

NOTE:  
 THE INFORMATION ON THIS PLAN IS COMPILED FROM VARIOUS SOURCES AND SHOULD BE VERIFIED PRIOR TO USE.  
 LOCATIONS SHOWN ARE APPROXIMATE ONLY AND SHOULD BE VERIFIED IN THE FIELD PRIOR TO WORK COMMENCING.

Table of Revisions

E13				
Number	Revision	Date	By	
0.	Revised	01-04-19		
	Revised	03-04-14		
	Revised	Oct. 2003	WR/JC	
	Revised	June 2004	WR/JC	
	Revised	June 2005	WR/JC	
	Revised	June 2007	WR	
	Added S-1713 Asbuilt	Nov. 2016	NS	





The Corporation  
 of the  
 City of Windsor

Engineering – Infrastructure & Geomatics



# SEWER ATLAS

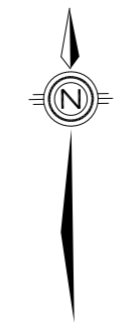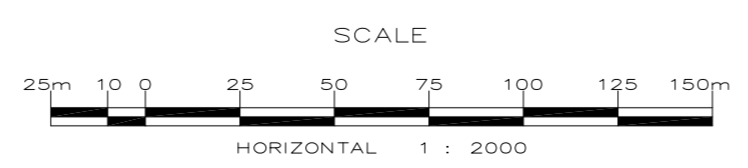

**Legend**

- SANITARY SEWER (Red dashed line)
- STORM SEWER (Blue dashed line)
- COMBINED SEWER (Green dashed line)
- PRIVATE SEWER (Purple dashed line)
- SANITARY PROPOSED OR AS BUILT INFO N/A (Red solid line)
- STORM PROPOSED OR AS BUILT INFO N/A (Blue solid line)
- CULVERTS, CATCH BASINS AND OUTLETS (Black dashed line)
- GAS LINE (Orange dashed line)
- STEAM LINE (Black dashed line)
- HYDRO ONE (Black dashed line)
- R.O.W (Black dashed line)
- ASSESSMENT LOT (Black dashed line)
- HERB GRAY PKWY LIMITS (Yellow dashed line)

**Manhole Location**

- Type: S=Sanitary, Re=Storm, C=Combined
- Manhole Number: 7R0000
- Location: N/A, 190.00, 190.00
- Top Elevation: 190.00

**Construction DWG Number**

- Manhole Number: 7R0000
- Location: N/A, 190.00, 190.00
- Top Elevation: 190.00
- Sanitary
- Storm
- Construction DWG Number: S-1000

**Other Symbols**

- Manhole Location: N/A, 190.00, 190.00
- Top Elevation: 190.00
- Sanitary
- Storm
- Construction DWG Number: S-1000

D12	E12	F12
D13	<b>E13</b>	F13
D14	E14	F14