


NOTE:
 THE INFORMATION ON THIS PLAN IS COMPILED FROM VARIOUS SOURCES AND SHOULD BE VERIFIED PRIOR TO USE.
 LOCATIONS SHOWN ARE APPROXIMATE ONLY AND SHOULD BE VERIFIED IN THE FIELD PRIOR TO WORK COMMENCING.



Number	Revision	Date	By
0.	Revised	June 2004	WR/JC
	Revised	June 2005	WR/JC
	Revised	June 2007	WR
	Added S-1911 As-Built	Sep 2013	MLR
	Added S-1955 Proposed	June 2015	NS
	Added S-1955 As-Built	July 2016	MLR
	Added S-2010 As-Built	Nov 2016	MLR
	Added S-2021 Proposed	May 2017	NS



The Corporation
 of the
 City of Windsor
 Engineering – Infrastructure & Geomatics

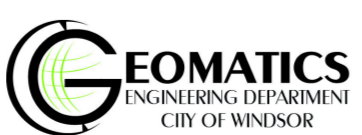

SEWER ATLAS

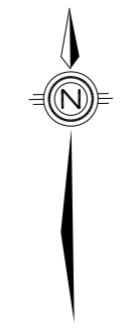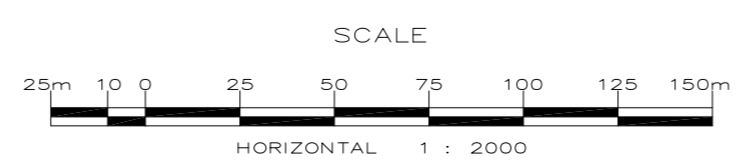

	SANITARY SEWER		STORM SEWER		COMBINED SEWER		PRIVATE SEWER		SANITARY PROPOSED OR AS BUILT INFO N/A		CULVERTS, CATCH BASINS AND OUTLETS		GAS LINE		STEAM LINE		HYDRO ONE		R.O.W		ASSESSMENT LOT		HERB GRAY PKWY LIMITS																																														
<table border="0"> <tr> <td>Type</td> <td>Manhole Number</td> <td>Location</td> <td>Top Elevation</td> </tr> <tr> <td>S=Sanitary</td> <td>700000</td> <td>N/A</td> <td>190.00</td> </tr> <tr> <td>Re-Storm</td> <td>Manhole Number</td> <td>Location</td> <td>Top Elevation</td> </tr> <tr> <td>C=Combined</td> <td>700000</td> <td>N/A</td> <td>190.00</td> </tr> <tr> <td>Manhole</td> <td>700000</td> <td>N/A</td> <td>190.00</td> </tr> <tr> <td>Location</td> <td>700000</td> <td>N/A</td> <td>190.00</td> </tr> <tr> <td>Top Elevation</td> <td>700000</td> <td>N/A</td> <td>190.00</td> </tr> </table>												Type	Manhole Number	Location	Top Elevation	S=Sanitary	700000	N/A	190.00	Re-Storm	Manhole Number	Location	Top Elevation	C=Combined	700000	N/A	190.00	Manhole	700000	N/A	190.00	Location	700000	N/A	190.00	Top Elevation	700000	N/A	190.00	<table border="0"> <tr> <td>Type</td> <td>Manhole Number</td> <td>Location</td> <td>Top Elevation</td> </tr> <tr> <td>S=Sanitary</td> <td>700000</td> <td>N/A</td> <td>190.00</td> </tr> <tr> <td>Re-Storm</td> <td>Manhole Number</td> <td>Location</td> <td>Top Elevation</td> </tr> <tr> <td>C=Combined</td> <td>700000</td> <td>N/A</td> <td>190.00</td> </tr> <tr> <td>Manhole</td> <td>700000</td> <td>N/A</td> <td>190.00</td> </tr> <tr> <td>Location</td> <td>700000</td> <td>N/A</td> <td>190.00</td> </tr> <tr> <td>Top Elevation</td> <td>700000</td> <td>N/A</td> <td>190.00</td> </tr> </table>		Type	Manhole Number	Location	Top Elevation	S=Sanitary	700000	N/A	190.00	Re-Storm	Manhole Number	Location	Top Elevation	C=Combined	700000	N/A	190.00	Manhole	700000	N/A	190.00	Location	700000	N/A	190.00	Top Elevation	700000	N/A	190.00
Type	Manhole Number	Location	Top Elevation																																																																		
S=Sanitary	700000	N/A	190.00																																																																		
Re-Storm	Manhole Number	Location	Top Elevation																																																																		
C=Combined	700000	N/A	190.00																																																																		
Manhole	700000	N/A	190.00																																																																		
Location	700000	N/A	190.00																																																																		
Top Elevation	700000	N/A	190.00																																																																		
Type	Manhole Number	Location	Top Elevation																																																																		
S=Sanitary	700000	N/A	190.00																																																																		
Re-Storm	Manhole Number	Location	Top Elevation																																																																		
C=Combined	700000	N/A	190.00																																																																		
Manhole	700000	N/A	190.00																																																																		
Location	700000	N/A	190.00																																																																		
Top Elevation	700000	N/A	190.00																																																																		
<table border="0"> <tr> <td>Pipe Length</td> <td>Pipe Size</td> <td>Pipe Material</td> </tr> <tr> <td>100.85m</td> <td>1200mm CP</td> <td>S-1000 CONSTRUCTION DWG NUMBER</td> </tr> </table>												Pipe Length	Pipe Size	Pipe Material	100.85m	1200mm CP	S-1000 CONSTRUCTION DWG NUMBER																																																				
Pipe Length	Pipe Size	Pipe Material																																																																			
100.85m	1200mm CP	S-1000 CONSTRUCTION DWG NUMBER																																																																			

D7	E7	F7
D8	E8	F8
D9	E9	F9