
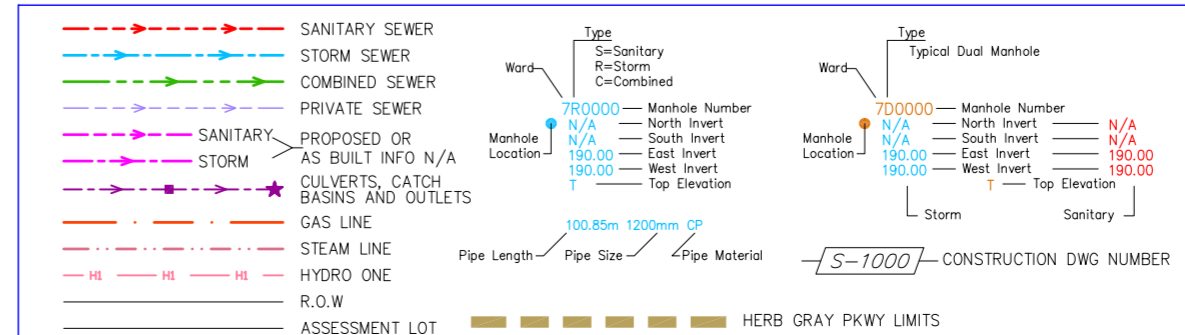


NOTE:  
 THE INFORMATION ON THIS PLAN IS COMPILED FROM VARIOUS SOURCES AND SHOULD BE VERIFIED PRIOR TO USE.  
 LOCATIONS SHOWN ARE APPROXIMATE ONLY AND SHOULD BE VERIFIED IN THE FIELD PRIOR TO WORK COMMENCING.

Table of Revisions

F11			
Number	Revision	Date	By
0.	Revised	03-04-14	
	Revised	Oct. 2003	WR/JC
	Revised	June 2004	WR/JC
	Revised	June 2005	WR/JC
	Revised	June 2007	WR
	Added S-1954 As-built	Sep 2012	MLR
	Revised	Dec. 2017	NS

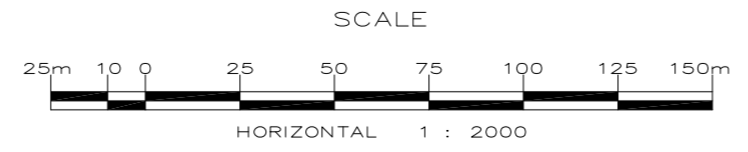

E10	F10	G10
E11	<b>F11</b>	G11
E12	F12	G12