

NOTE:
 THE INFORMATION ON THIS PLAN IS COMPILED FROM VARIOUS SOURCES AND SHOULD BE VERIFIED PRIOR TO USE.
 LOCATIONS SHOWN ARE APPROXIMATE ONLY AND SHOULD BE VERIFIED IN THE FIELD PRIOR TO WORK COMMENCING.

Table of Revisions


F5			
Number	Revision	Date	By
0.	Revised	June 2004	WR/JC
	Revised	June 2005	WR/JC
	Revised	June 2007	WR
	Added S-1864 & S-1891 Proposed	Mar 2010	MLR
	Added S-1864 & S-1891 As-built	May 2011	MLR
	Added S-1981 Proposed	Mar 2014	MLR
	Revised	Dec. 2017	NS
	Added S-1981 As-built	Oct. 2019	NS



The Corporation
 of the
 City of Windsor
 Engineering – Infrastructure & Geomatics



SEWER ATLAS

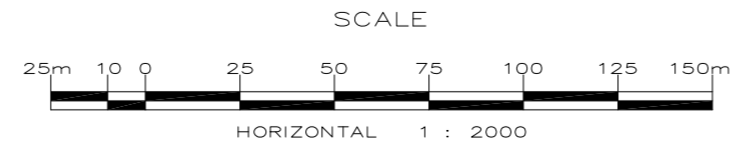

Legend

- SANITARY SEWER (Red dashed line)
- STORM SEWER (Blue dashed line)
- COMBINED SEWER (Green dashed line)
- PRIVATE SEWER (Purple dashed line)
- SANITARY PROPOSED OR AS BUILT INFO N/A (Red solid line)
- STORM (Blue solid line)
- CULVERTS, CATCH BASINS AND OUTLETS (Star symbol)
- GAS LINE (Orange solid line)
- STEAM LINE (Yellow solid line)
- HYDRO ONE (Light blue solid line)
- R.O.W. (Black dashed line)
- ASSESSMENT LOT (Black outline)
- HERB GRAY PKWY LIMITS (Yellow dashed line)

Manhole Symbols

- Type: S=Sanitary, Re=Storm, C=Combined
- Manhole Location: 780000 (North Invert), 190.00 (South Invert), 190.00 (East Invert), 190.00 (West Invert), 190.00 (Top Elevation)
- Manhole Number: 780000 (North Invert), 190.00 (South Invert), 190.00 (East Invert), 190.00 (West Invert), 190.00 (Top Elevation)

Construction Drawing Number

S-1000

E4	F4	G4
E5	F5	G5
E6	F6	G6