

NOTE:
 THE INFORMATION ON THIS PLAN IS COMPILED FROM VARIOUS SOURCES AND SHOULD BE VERIFIED PRIOR TO USE.
 LOCATIONS SHOWN ARE APPROXIMATE ONLY AND SHOULD BE VERIFIED IN THE FIELD PRIOR TO WORK COMMENCING.

Table of Revisions


F6			
Number	Revision	Date	By
0.	Added S-1891 Proposed	Mar 2010	MLR
	Added S-1891 As-builts	May 2011	MLR
	Added S-1934 Proposed	Apr 2012	MLR
	Added S-1946 Proposed	Mar 2013	MLR
	Added S-1981 Proposed	Mar 2014	MLR
	Revised	Dec 2017	NS
	Added S-1946 As-Built	May 2019	PR
	Added S-1981 As-built	Oct. 2019	NS



The Corporation
 of the
 City of Windsor
 Engineering – Infrastructure & Geomatics



SEWER ATLAS

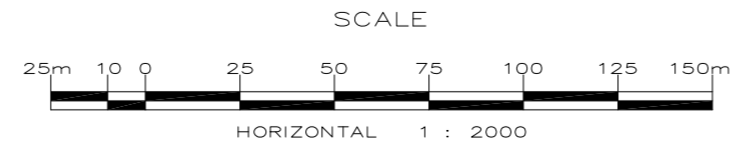

Legend

- SANITARY SEWER (Blue dashed line)
- STORM SEWER (Green dashed line)
- COMBINED SEWER (Red dashed line)
- PRIVATE SEWER (Purple dashed line)
- SANITARY PROPOSED OR AS BUILT INFO N/A (Pink dashed line)
- STORM CULVERTS, CATCH BASINS AND OUTLETS (Blue dashed line with arrows)
- GAS LINE (Orange dashed line)
- STEAM LINE (Yellow dashed line)
- HYDRO ONE (Light blue dashed line)
- R.O.W. (Red dashed line)
- ASSESSMENT LOT (Black dashed line)
- HERB GRAY PKWY LIMITS (Brown dashed line)

Manhole Symbols

- Type: S=Sanitary, e=Storm, C=Combined
- Manhole Location: 7R00000 - Manhole Number, North Invert, South Invert, East Invert, West Invert, Top Elevation
- Typical Dual Manhole: 7R00000 - Manhole Number, North Invert, South Invert, East Invert, West Invert, Top Elevation

Other Symbols

- Sturm (Blue dashed line with arrows)
- Sanitary (Blue dashed line)
- Construction Drawing Number: S-1000
- Pipe Length, Pipe Size, Pipe Material

E5	F5	G5
E6	F6	G6
E7	F7	G7