


NOTE:
 THE INFORMATION ON THIS PLAN IS COMPILED FROM VARIOUS SOURCES AND SHOULD BE VERIFIED PRIOR TO USE.
 LOCATIONS SHOWN ARE APPROXIMATE ONLY AND SHOULD BE VERIFIED IN THE FIELD PRIOR TO WORK COMMENCING.

Table of Revisions

F7			
Number	Revision	Date	By
0.	Revised	Oct. 2003	WR/JC
	Revised	June 2004	WR/JC
	Revised	June 2005	WR/JC
	Revised	June 2007	WR
	Revised	Oct. 2008	JM
	Added S-1873 Proposed	Nov. 2010	MLR
	Added S-1716 As Built	Jul. 2014	MLR
	Revised	Dec. 2017	NS

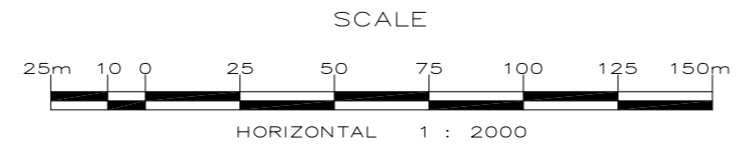

Legend for Sewer Lines and Manholes:

- SANITARY SEWER (Red dashed line)
- STORM SEWER (Blue dashed line)
- COMBINED SEWER (Green dashed line)
- PRIVATE SEWER (Purple dashed line)
- SANITARY PROPOSED OR AS BUILT INFO N/A (Red dashed line with dots)
- STORM (Blue dashed line with dots)
- CULVERTS, CATCH BASINS AND OUTLETS (Blue dashed line with triangles)
- GAS LINE (Orange dashed line)
- STEAM LINE (Yellow dashed line)
- HYDRO ONE (Green dashed line)
- R.O.W. (Red dashed line)
- ASSESSMENT LOT (Black dashed line)
- HERB GRAY PKWY LIMITS (Black dashed line)

Manhole Information:

- Type: S=Sanitary, Re=Storm, C=Combined
- Manhole Number: 7R00000
- Location: North Invert, South Invert, East Invert, West Invert, Top Elevation
- Typical Dual Manhole: 7R00000
- Manhole Number: 7R00000
- Location: North Invert, South Invert, East Invert, West Invert, Top Elevation

Other Symbols:

- Interceptor chamber
- See K-1 Relief Storm Sewer
- 100.85m 1200mm CP (Pipe Length, Pipe Size, Pipe Material)
- S-1000 CONSTRUCTION DWG NUMBER

E6	F6	G6
E7	F7	G7
E8	F8	G8