

NOTE:
 THE INFORMATION ON THIS PLAN IS COMPILED FROM VARIOUS SOURCES AND SHOULD BE VERIFIED PRIOR TO USE.
 LOCATIONS SHOWN ARE APPROXIMATE ONLY AND SHOULD BE VERIFIED IN THE FIELD PRIOR TO WORK COMMENCING.

Table of Revisions



Number	Revision	Date	By
0.	Revised	June 2004	WR/JC
	Revised	June 2005	WR/JC
	Revised	June 2007	WR
	Added S-1832 Proposed	June 2007	WR
	Revised	May 2013	WR
	Added S-1965 Proposed	July 2013	MLR
	S-1953 As-built	May 2014	MLR
	Revised	Dec. 2017	NS



The Corporation
 of the
 City of Windsor
 Engineering – Infrastructure & Geomatics



SEWER ATLAS

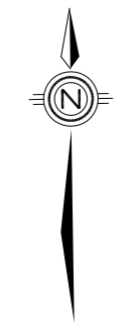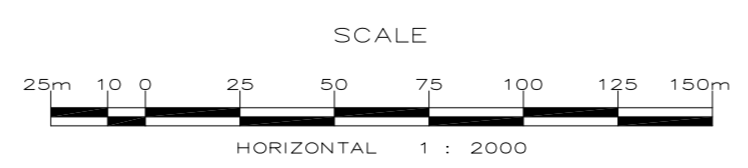

Legend

- SANITARY SEWER (Red dashed line)
- STORM SEWER (Blue dashed line)
- COMBINED SEWER (Green dashed line)
- PRIVATE SEWER (Purple dashed line)
- SANITARY PROPOSED OR AS BUILT (Red solid line)
- STORM (Blue solid line)
- CULVERTS, CATCH BASINS AND OUTLETS (Yellow dashed line)
- GAS LINE (Orange dashed line)
- STEAM LINE (Black dashed line)
- HYDRO ONE (Black dashed line)
- R.O.W. (Black dashed line)
- ASSESSMENT LOT (Black dashed line)
- HERB GRAY PKWY LIMITS (Black dashed line)

Manhole Location

- Type: S=Sanitary, R=Storm, C=Combined
- Manhole Number: 7R0000
- Location: North Invert, South Invert, East Invert, West Invert, Top Elevation
- Manhole Location: 7R0000
- Location: North Invert, South Invert, East Invert, West Invert, Top Elevation

Construction DWG Number

- S-1000

G9	H9	I9
G10	H10	I10
G11	H11	I11