

NOTE:
 THE INFORMATION ON THIS PLAN IS COMPILED FROM VARIOUS SOURCES AND SHOULD BE VERIFIED PRIOR TO USE.
 LOCATIONS SHOWN ARE APPROXIMATE ONLY AND SHOULD BE VERIFIED IN THE FIELD PRIOR TO WORK COMMENCING.

Table of Revisions

H7			
Number	Revision	Date	By
0.	Revised	01-04-19	
	Revised	Oct. 2003	WR/JC
	Revised	June 2004	WR/JC
	Revised	June 2005	WR/JC
	Revised	June 2007	WR
	Added S-1845 Proposed	Dec. 2010	MLR
	Revised	Nov. 2017	NS
	Added S-1768 As-Built	July 2019	PR




The Corporation
 of the
 City of Windsor

Engineering – Infrastructure & Geomatics



SEWER ATLAS

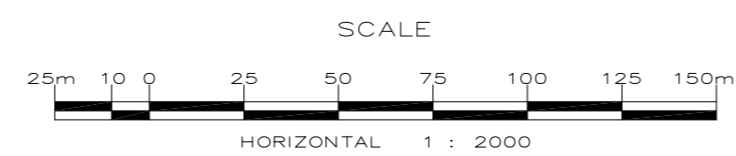

Legend

- SANITARY SEWER (Red dashed line)
- STORM SEWER (Blue dashed line)
- COMBINED SEWER (Green dashed line)
- PRIVATE SEWER (Magenta dashed line)
- SANITARY PROPOSED OR AS BUILT INFO N/A (Red dashed line with dots)
- STORM (Blue dashed line with dots)
- CULVERTS, CATCH BASINS AND OUTLETS (Star symbol)
- GAS LINE (Orange dashed line)
- STEAM LINE (Yellow dashed line)
- HYDRO ONE (Light blue dashed line)
- R.O.W. (Red dashed line)
- ASSESSMENT LOT (Black dashed line)
- HERB GRAY PKWY LIMITS (Brown dashed line)

Manhole Symbols

- Type: S=Sanitary, R=Storm, C=Combined
- Manhole Location: 7R00000 - Manhole Number
- North Invert: 190.00
- South Invert: 190.00
- East Invert: 190.00
- West Invert: 190.00
- Top Elevation: 190.00

Pipe Symbols

- Pipe Length: 100.85m, 120.00m CP
- Pipe Size: 100mm CP
- Pipe Material: S-1000 CONSTRUCTION DWG NUMBER

G6	H6	16
G7	H7	17
G8	H8	18