

NOTE:
 THE INFORMATION ON THIS PLAN IS COMPILED FROM VARIOUS SOURCES AND SHOULD BE VERIFIED PRIOR TO USE.
 LOCATIONS SHOWN ARE APPROXIMATE ONLY AND SHOULD BE VERIFIED IN THE FIELD PRIOR TO WORK COMMENCING.

Table of Revisions


I14			
Number	Revision	Date	By
0.	Revised	Oct. 2003	WR/JC
	Revised	June 2004	WR/JC
	Revised	June 2005	WR/JC
	Revised	June 2007	WR
	Added S-1991 As-built	Dec 2014	MLR
	Added S-2048 Proposed	Jan 2018	NS
	Added S-2048 As-built	Mar. 2018	NS
	Added S-2067 As-built	Feb. 2019	NS



The Corporation
 of the
 City of Windsor
 Engineering – Infrastructure & Geomatics



SEWER ATLAS

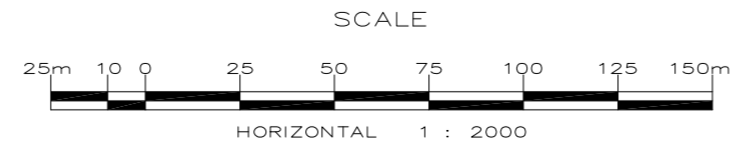

Legend

- SANITARY SEWER (Red dashed line)
- STORM SEWER (Blue dashed line)
- COMBINED SEWER (Green dashed line)
- PRIVATE SEWER (Purple dashed line)
- SANITARY PROPOSED OR AS BUILT INFO N/A (Red solid line)
- STORM (Blue solid line)
- CULVERTS, CATCH BASINS AND OUTLETS (Yellow dashed line)
- GAS LINE (Orange dashed line)
- STEAM LINE (Black dashed line)
- HYDRO ONE (Black solid line)
- R.O.W. (Red solid line)
- ASSESSMENT LOT (Black dashed line)
- HERB GRAY PKWY LIMITS (Yellow dashed line)

Manhole Location

- Type: S=Sanitary, R=Storm, C=Combined
- Manhole Number: 7R0000
- Location: North Invert, South Invert, East Invert, West Invert, Top Elevation

Typical Dual Manhole

- Type: S=Sanitary, R=Storm
- Manhole Number: 7R0000
- Location: North Invert, South Invert, East Invert, West Invert, Top Elevation

Other Symbols

- Pipe Length: 100.85m, 120.00m CP
- Pipe Size: 4" Pipe Material
- Construction DWG Number: S-1000

H13	I13	J13
H14	I14	J14
H15	I15	J15