

NOTE:  
 THE INFORMATION ON THIS PLAN IS COMPILED FROM VARIOUS SOURCES AND SHOULD BE VERIFIED PRIOR TO USE.  
 LOCATIONS SHOWN ARE APPROXIMATE ONLY AND SHOULD BE VERIFIED IN THE FIELD PRIOR TO WORK COMMENCING.

Table of Revisions



Number	Revision	Date	By
0.	Revised	01-04-19	
	Revised	03-06-04	
	Revised	Oct. 2003	WR/JC
	Revised	June 2004	WR/JC
	Revised	June 2005	WR/JC
	Revised	June 2007	WR
	Added S-1607 Proposed	Nov. 2017	NS
	Added P-1980 As-built	Sep. 2019	PR



The Corporation  
 of the  
 City of Windsor  
 Engineering – Infrastructure & Geomatics



# SEWER ATLAS

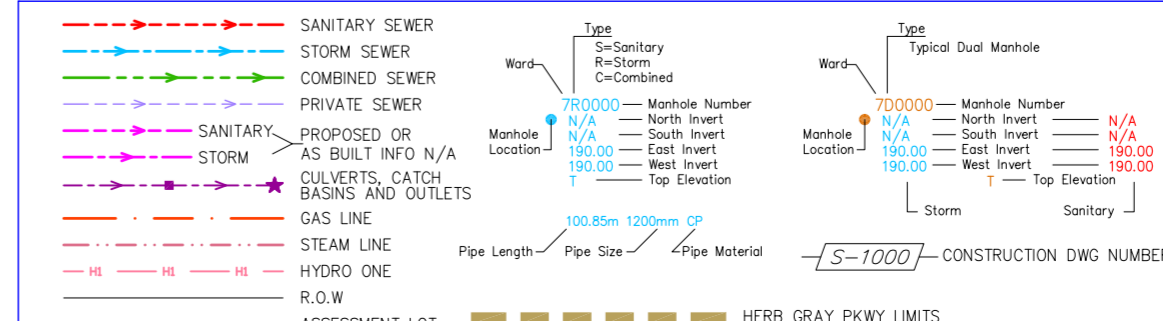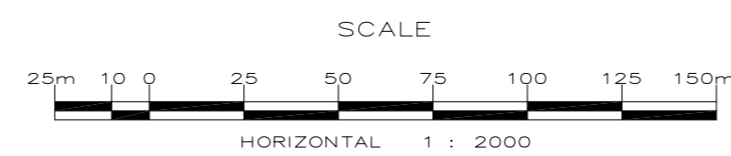

H4	14	J4
H5	15	J5
H6	16	J6