

NOTE:  
 THE INFORMATION ON THIS PLAN IS COMPILED FROM VARIOUS SOURCES AND SHOULD BE VERIFIED PRIOR TO USE.  
 LOCATIONS SHOWN ARE APPROXIMATE ONLY AND SHOULD BE VERIFIED IN THE FIELD PRIOR TO WORK COMMENCING.

Table of Revisions


J14			
Number	Revision	Date	By
0.	Revised	03-06-04	
	Revised	Oct. 2003	WR/JC
	Revised	June 2004	WR/JC
	Revised	June 2005	WR/JC
	Revised	June 2007	WR
	Added S-2055 Proposed	Nov. 2017	NS
	Added S-2055 As Built	May 2018	NS
	Added S-2067 As-built	Feb. 2019	NS



The Corporation  
 of the  
 City of Windsor  
 Engineering – Infrastructure & Geomatics



# SEWER ATLAS

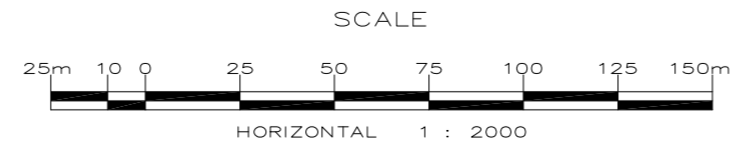

**Legend**

- SANITARY SEWER (Red dashed line)
- STORM SEWER (Blue dashed line)
- COMBINED SEWER (Green dashed line)
- PRIVATE SEWER (Purple dashed line)
- SANITARY PROPOSED OR AS BUILT INFO N/A (Red solid line)
- STORM (Blue solid line)
- CULVERTS, CATCH BASINS AND OUTLETS (Yellow dashed line)
- GAS LINE (Orange dashed line)
- STEAM LINE (Black dashed line)
- HYDRO ONE (Black solid line)
- R.O.W. (Black solid line)
- ASSESSMENT LOT (Black solid line)
- HERB GRAY PKWY LIMITS (Black dashed line)

**Manhole Location**

- Type S=Sanitary
- Type Re=Storm
- Type C=Combined
- Manhole Location: 7R00000 - Manhole Number
- Manhole Location: 190.00 - North Invert
- Manhole Location: 190.00 - South Invert
- Manhole Location: 190.00 - East Invert
- Manhole Location: 190.00 - West Invert
- Manhole Location: 190.00 - Top Elevation

**Typical Dual Manhole**

- Type S=Sanitary
- Type Re=Storm
- Type C=Combined
- Manhole Location: 7R00000 - Manhole Number
- Manhole Location: 190.00 - North Invert
- Manhole Location: 190.00 - South Invert
- Manhole Location: 190.00 - East Invert
- Manhole Location: 190.00 - West Invert
- Manhole Location: 190.00 - Top Elevation

**Construction DWG Number**

- S-1000

**Other Symbols**

- Sanitary
- Storm
- 100.85m 1200mm CP
- Pipe Length - Pipe Size - Pipe Material

I13	J13	K13
I14	<b>J14</b>	K14
I15	J15	K15