

NOTE:
 THE INFORMATION ON THIS PLAN IS COMPILED FROM VARIOUS SOURCES AND SHOULD BE VERIFIED PRIOR TO USE.
 LOCATIONS SHOWN ARE APPROXIMATE ONLY AND SHOULD BE VERIFIED IN THE FIELD PRIOR TO WORK COMMENCING.

Table of Revisions


J4			
Number	Revision	Date	By
0.	Revised	Oct. 2008	JM
	As built for S-1863	Jan. 2010	MLR
	Added S-1918	Aug. 2013	MLR
	Added S-1871 As-built	Oct. 2013	MLR
	Added S-1977	Apr. 2014	MLR
	Added S-2053	Sep. 2017	NS
	Added S-2056 Proposed	June 2018	NS
	Added S-2046 As-built	Dec. 2018	NS



The Corporation
 of the
 City of Windsor
 Engineering – Infrastructure & Geomatics



SEWER ATLAS

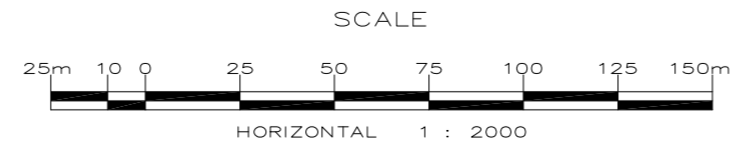

<ul style="list-style-type: none"> --- SANITARY SEWER --- STORM SEWER --- COMBINED SEWER --- PRIVATE SEWER --- SANITARY PROPOSED OR AS BUILT INFO N/A --- STORM --- CULVERTS, CATCH BASINS AND OUTLETS --- GAS LINE --- STEAM LINE --- HYDRO ONE --- R.O.W. ASSESSMENT LOT HERB GRAY PKWY LIMITS 	<p>Type</p> <ul style="list-style-type: none"> ● Manhole Number ● North Invert ● South Invert ● East Invert ● West Invert ● Top Elevation <p>Manhole Location</p> <ul style="list-style-type: none"> ○ 780000 ○ 190.00 ○ 190.00 ○ 190.00 <p>Pipe Length</p> <ul style="list-style-type: none"> --- Pipe Size --- Pipe Material 	<p>Type</p> <ul style="list-style-type: none"> --- Manhole Number --- North Invert --- South Invert --- East Invert --- West Invert --- Top Elevation <p>Manhole Location</p> <ul style="list-style-type: none"> ○ 780000 ○ 190.00 ○ 190.00 ○ 190.00 <p>Storm</p> <ul style="list-style-type: none"> --- Sanitary
---	---	--

S-1000 CONSTRUCTION DWG NUMBER

13	J3	K3
14	J4	K4
15	J5	K5