

There is a development agreement dated Sep-8-01 between the Corporation and Holiday Juice, where by the Corporation agrees to maintain access, should work be require on the combined sewer.

NOTE:
THE INFORMATION ON THIS PLAN IS COMPILED FROM VARIOUS SOURCES AND SHOULD BE VERIFIED PRIOR TO USE.
LOCATIONS SHOWN ARE APPROXIMATE ONLY AND SHOULD BE VERIFIED IN THE FIELD PRIOR TO WORK COMMENCING.

Table of Revisions

K4			
Number	Revision	Date	By
0.	Revised	June 2004	WR/JC
	Revised	June 2005	WR/JC
	Revised	June 2007	WR
	Added S-1960 Proposed	Oct. 2013	MLR
	Added S-1871 As-built	Oct. 2013	MLR
	Revised	Oct. 2014	NS
	Added S-1960 As-built	Nov. 2015	MLR
	Revised	Aug. 2017	NS





The Corporation
of the
City of Windsor

Engineering – Infrastructure & Geomatics



SEWER ATLAS

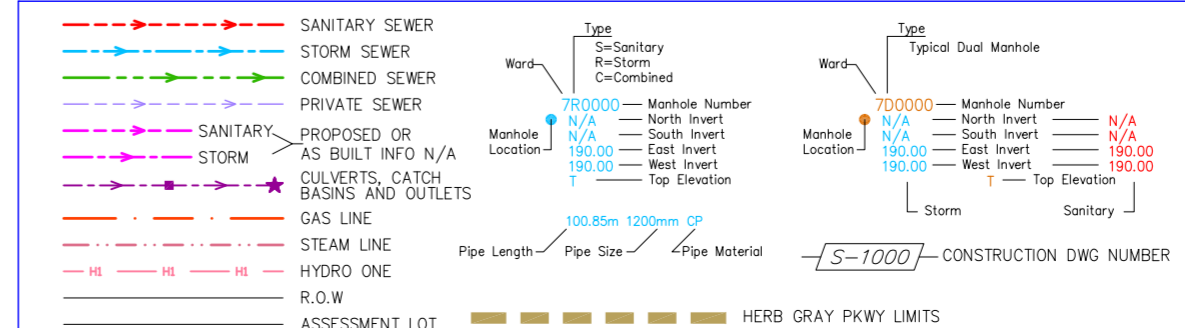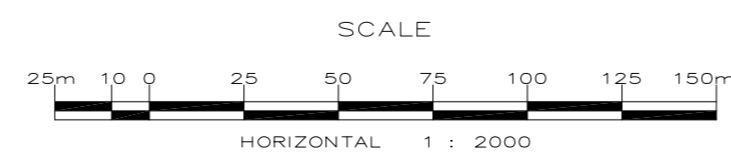

J3	K3	L3
J4	K4	L4
J5	K5	L5