

NOTE:
 THE INFORMATION ON THIS PLAN IS COMPILED FROM VARIOUS SOURCES AND SHOULD BE VERIFIED PRIOR TO USE.
 LOCATIONS SHOWN ARE APPROXIMATE ONLY AND SHOULD BE VERIFIED IN THE FIELD PRIOR TO WORK COMMENCING.


Table of Revisions

K7			
Number	Revision	Date	By
0.	Revised	June 2005	WR/JC
	Revised	June 2007	WR
	Revised	Oct. 2008	JM
	Added S-1958 Proposed	Dec. 2012	MLR
	Added S-1500 As-Built	Mar 2015	MLR
	Added S-1848 As-built	Apr 2015	MLR
	Added S-1900	Mar. 2017	NS
	Added S-1900 As-built	Mar. 2019	NS




The Corporation
 of the
 City of Windsor

Engineering – Infrastructure & Geomatics

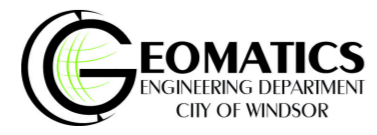

SEWER ATLAS

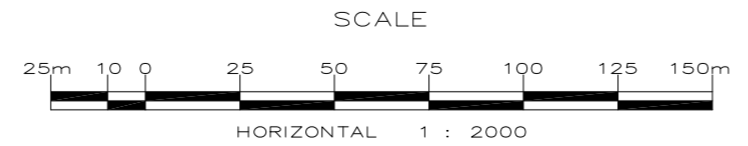

Legend for Sewer Lines and Manholes:

- SANITARY SEWER (Red dashed line)
- STORM SEWER (Blue dashed line)
- COMBINED SEWER (Green dashed line)
- PRIVATE SEWER (Black dashed line)
- SANITARY PROPOSED OR AS BUILT INFO N/A (Red dashed line with 'P' or 'A' label)
- STORM (Blue dashed line with 'S' label)
- CULVERTS, CATCH BASINS AND OUTLETS (Black dashed line with 'C' label)
- GAS LINE (Orange dashed line)
- STEAM LINE (Yellow dashed line)
- HYDRO ONE (Purple dashed line)
- R.O.W. (Red dashed line)
- ASSESSMENT LOT (Black dashed line)
- HERB GRAY PKWY LIMITS (Yellow dashed line)

Manhole Location Legend:

- Type: S=Sanitary, R=Storm, C=Combined
- Manhole Location: 7R00000 (North Invert), 7R00000 (South Invert), 7R00000 (East Invert), 7R00000 (West Invert), 7R00000 (Top Elevation)
- Type: Typical Dual Manhole
- Manhole Location: 7R00000 (North Invert), 7R00000 (South Invert), 7R00000 (East Invert), 7R00000 (West Invert), 7R00000 (Top Elevation)

Construction Details Legend:

- 100.85m 1200mm CP (Orange dashed line)
- S-1000 CONSTRUCTION DWG NUMBER (Black dashed line)

J6	K6	L6
J7	K7	L7
J8	K8	L8