

NOTE:
 THE INFORMATION ON THIS PLAN IS COMPILED FROM VARIOUS SOURCES AND SHOULD BE VERIFIED PRIOR TO USE.
 LOCATIONS SHOWN ARE APPROXIMATE ONLY AND SHOULD BE VERIFIED IN THE FIELD PRIOR TO WORK COMMENCING.

Table of Revisions

Number	Revision	Date	By
0.	Revised	Oct. 2003	WR/JC
	Revised	June 2004	WR/JC
	Revised	June 2005	WR/JC
	Revised	June 2007	WR
	Added S-2018 Proposed	Dec 2015	MLR
	Added S-2041 Proposed	Nov 2016	MLR
	Revised	Nov. 2017	NS
	Added S-2018 As-built	Jan. 2019	PR





The Corporation
 of the
 City of Windsor

Engineering – Infrastructure & Geomatics



SEWER ATLAS

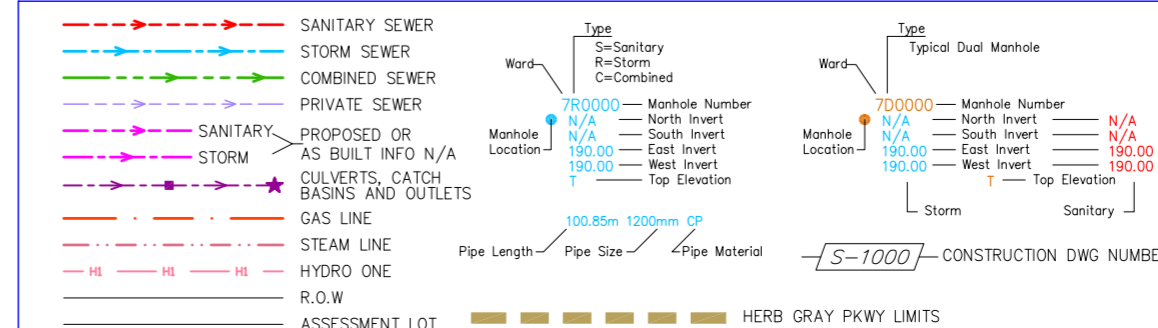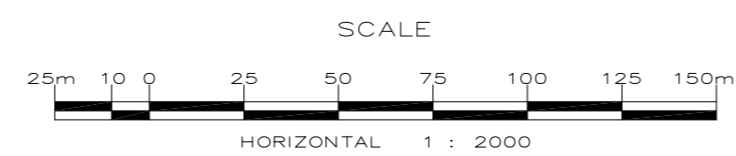

K10	L10	M10
K11	L11	M11
K12	L12	M12