


NOTE:  
 THE INFORMATION ON THIS PLAN IS COMPILED FROM VARIOUS SOURCES AND SHOULD BE VERIFIED PRIOR TO USE.  
 LOCATIONS SHOWN ARE APPROXIMATE ONLY AND SHOULD BE VERIFIED IN THE FIELD PRIOR TO WORK COMMENCING.

Table of Revisions

L13			
Number	Revision	Date	By
0.	Revised	03-06-04	
	Revised	Oct. 2003	WR/JC
	Revised	June 2004	WR/JC
	Revised	June 2005	WR/JC
	Revised	June 2007	WR
	Added P-1976 Proposed	Sept 2017	NS
	Added P-1976 As-built	Feb. 2018	NS
	Added P-1991 Proposed	Aug 2019	NS

# SEWER ATLAS

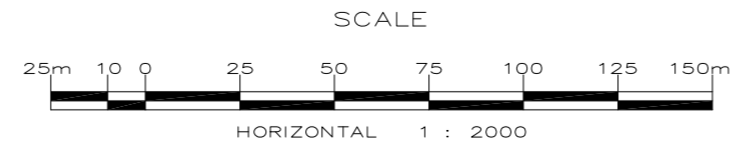

**Legend:**

- SANITARY SEWER (Red dashed line)
- STORM SEWER (Blue dashed line)
- COMBINED SEWER (Green dashed line)
- PRIVATE SEWER (Purple dashed line)
- SANITARY PROPOSED OR AS BUILT (Red solid line)
- STORM (Blue solid line)
- CULVERTS, CATCH BASINS AND OUTLETS (Yellow dashed line)
- GAS LINE (Orange dashed line)
- STEAM LINE (Black dashed line)
- HYDRO ONE (Black dashed line)
- R.O.W. (Black dashed line)
- ASSESSMENT LOT (Black dashed line)
- HERB GRAY PKWY LIMITS (Black dashed line)

**Manhole Location:**

- Type: S=Sanitary, R=Storm, C=Combined
- Manhole Number: 7R00000
- Location: North Invert, South Invert, East Invert, West Invert, Top Elevation

**Pipe Length:**

- Type: Sanitary, Storm, Combined
- Manhole Number: 7R00000
- Location: North Invert, South Invert, East Invert, West Invert, Top Elevation

**Construction DWG Number:** S-1000

K12	L12	M12
K13	L13	M13
K14	L14	M14