


**NOTE:**  
 THE INFORMATION ON THIS PLAN IS COMPILED FROM VARIOUS SOURCES AND SHOULD BE VERIFIED PRIOR TO USE.  
 LOCATIONS SHOWN ARE APPROXIMATE ONLY AND SHOULD BE VERIFIED IN THE FIELD PRIOR TO WORK COMMENCING.

**Table of Revisions**


Number	Revision	Date	By
0.	Revised	Oct. 2003	WR/JC
	Revised	June 2004	WR/JC
	Revised	June 2005	WR/JC
	Revised	June 2007	WR
	Added P-1956	Mar 2013	MLR
	Added S-1984 Proposed	May 2014	MLR
	Added S-1984 As-Built	Dec 2014	MLR
	Added P-1956 As-Built	June 2015	MLR



The Corporation  
 of the  
 City of Windsor  
 Engineering – Infrastructure & Geomatics

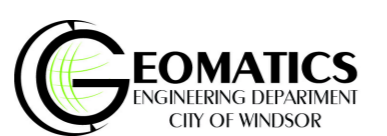

# SEWER ATLAS

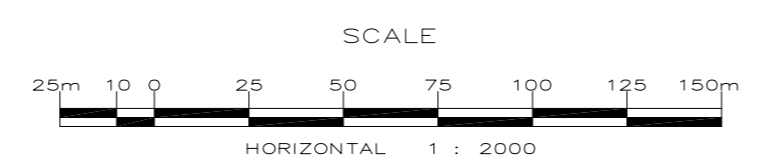

**Legend**

- SANITARY SEWER (Red dashed line)
- STORM SEWER (Blue dashed line)
- COMBINED SEWER (Green dashed line)
- PRIVATE SEWER (Purple dashed line)
- SANITARY PROPOSED OR AS BUILT INFO N/A (Red dashed line with 'P')
- STORM PROPOSED OR AS BUILT INFO N/A (Blue dashed line with 'S')
- CULVERTS, CATCH BASINS AND OUTLETS (Star symbol)
- GAS LINE (Orange dashed line)
- STEAM LINE (Yellow dashed line)
- HYDRO ONE (Light blue dashed line)
- R.O.W. (Black dashed line)
- ASSESSMENT LOT (Black outline)
- HERB GRAY PKWY LIMITS (Yellow dashed line)

**Manhole Location**

- Manhole Number: 700000
- North Invert: N/A
- South Invert: N/A
- East Invert: 190.00
- West Invert: 190.00
- Top Elevation: T

**Typical Dual Manhole**

- Manhole Number: 700000
- North Invert: N/A
- South Invert: N/A
- East Invert: 190.00
- West Invert: 190.00
- Top Elevation: T
- Sanitary
- Storm

**Construction Dwg Number**

- S-1000

**Pipe Length, Pipe Size, Pipe Material**

- 100.85m 1200mm CP

L9	M9	N9
L10	<b>M10</b>	N10
L11	M11	N11