


NOTE:  
 THE INFORMATION ON THIS PLAN IS COMPILED FROM VARIOUS SOURCES AND SHOULD BE VERIFIED PRIOR TO USE.  
 LOCATIONS SHOWN ARE APPROXIMATE ONLY AND SHOULD BE VERIFIED IN THE FIELD PRIOR TO WORK COMMENCING.

Table of Revisions


Number	Revision	Date	By
0.	Revised	June 2005	WR/JC
	Revised	June 2007	WR
	Added P-1954	Apr 2012	MLR
	Added S-1959 As-Built for Phase 3A-2	July 2013	MLR
	Added P-1954 As-Built	Mar 2014	MLR
	Added S-1959 As-Built for Phase 3C	July 2014	MLR
	Added P-1976 Proposed	Sept 2017	NS
	Added P-1976 As-Built	Feb. 2018	NS



The Corporation  
 of the  
 City of Windsor  
 Engineering – Infrastructure & Geomatics

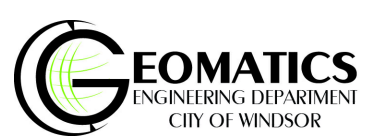

# SEWER ATLAS

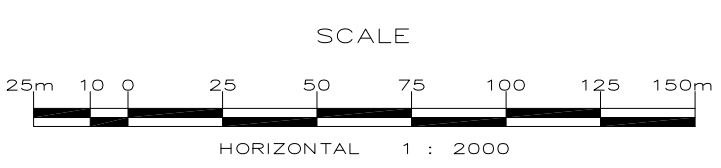

**Legend**

- SANITARY SEWER (Blue dashed line)
- STORM SEWER (Green dashed line)
- COMBINED SEWER (Red dashed line)
- PRIVATE SEWER (Yellow dashed line)
- SANITARY PROPOSED OR AS BUILT INFO N/A (Blue solid line)
- STORM (Green solid line)
- CULVERTS, CATCH BASINS AND OUTLETS (Purple solid line)
- GAS LINE (Orange solid line)
- STEAM LINE (Light blue solid line)
- HYDRO ONE (Light green solid line)
- R.O.W. (Red solid line)
- ASSESSMENT LOT (Black solid line)
- HERB GRAY PKWY LIMITS (Yellow dashed line)

**Manhole Symbols**

- Sanitary: Blue circle with 'S' and number
- Storm: Green circle with 'ST' and number
- Combined: Red circle with 'C' and number
- Private: Yellow circle with 'P' and number
- Proposed/As-Built: Blue circle with 'S' and number
- Culvert: Purple circle with 'C' and number
- Gas: Orange circle with 'G' and number
- Steam: Light blue circle with 'S' and number
- Hydro One: Light green circle with 'H' and number
- Typical Dual Manhole: Circle with 'S' and 'ST' and number

**Notes**

- Manhole Location: N/A, North Invert, South Invert, East Invert, West Invert, Top Elevation
- Pipe Length: 100.85m, 1200mm CP
- Pipe Size: 150mm, 200mm, 300mm, 450mm, 600mm, 900mm, 1200mm
- Pipe Material: PVC, CP, HDPE, etc.
- Construction DWG Number: S-1000

L12	M12	N12
L13	M13	N13
L14	M14	N14