


NOTE:  
 THE INFORMATION ON THIS PLAN IS COMPILED FROM VARIOUS SOURCES AND SHOULD BE VERIFIED PRIOR TO USE.  
 LOCATIONS SHOWN ARE APPROXIMATE ONLY AND SHOULD BE VERIFIED IN THE FIELD PRIOR TO WORK COMMENCING.

Table of Revisions


Number	Revision	Date	By
0.	Revised	03-07-04	WR/JC
	Revised	Oct. 2003	WR/JC
	Revised	June 2005	WR/JC
	Revised	June 2007	WR
	Added S-1959 As-builts for Phase 3A-2	July 2013	MLR
	Added S-1959 As-builts for Phase 3C	July 2014	MLR
	Added S-2037 As-builts for Phase 3D	June 2016	MLR
	Added S-2049 As-built	Oct. 2018	NS



The Corporation  
 of the  
 City of Windsor  
 Engineering – Infrastructure & Geomatics

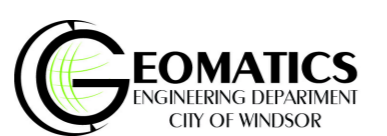

# SEWER ATLAS

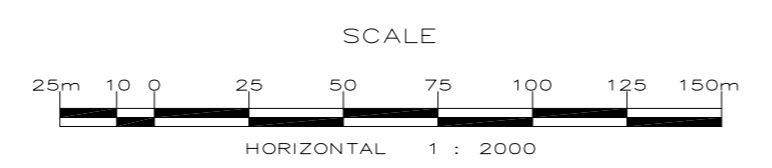

**Legend**

- SANITARY SEWER (Red dashed line)
- STORM SEWER (Blue dashed line)
- COMBINED SEWER (Green dashed line)
- PRIVATE SEWER (Purple dashed line)
- SANITARY PROPOSED OR AS BUILT INFO N/A (Red dashed line with 'P')
- STORM PROPOSED OR AS BUILT INFO N/A (Blue dashed line with 'P')
- CULVERTS, CATCH BASINS AND OUTLETS (Black dashed line)
- GAS LINE (Orange dashed line)
- STEAM LINE (Yellow dashed line)
- HYDRO ONE (Light blue dashed line)
- R.O.W. (Black dashed line)
- ASSESSMENT LOT (Black dashed line)
- HERB GRAY PKWY LIMITS (Yellow dashed line)

**Manhole Symbols**

- Sanitary: Circle with 'S' and number
- Storm: Circle with 'S' and number
- Combined: Circle with 'S' and number
- Private: Circle with 'S' and number
- Proposed/As-Built: Circle with 'S' and number, and 'P' or 'A'

**Construction Drawing Number**

S-1000

L13	M13	N13
L14	<b>M14</b>	N14
L15	M15	N15