


NOTE:  
 THE INFORMATION ON THIS PLAN IS COMPILED FROM VARIOUS SOURCES AND SHOULD BE VERIFIED PRIOR TO USE.  
 LOCATIONS SHOWN ARE APPROXIMATE ONLY AND SHOULD BE VERIFIED IN THE FIELD PRIOR TO WORK COMMENCING.

Table of Revisions


Number	Revision	Date	By
0.	Revised	June 2005	WR/JC
	Revised	June 2007	WR
	Added S-1615 As-built Information	Apr 2010	MLR
	Added S-1846 & S-1879 Proposed	June 2010	MLR
	Added S-1879 As-built	Sep 2014	MLR
	Added S-1987	Jan 2015	MLR
	Added S-1841 As-built	Apr 2015	MLR
	Added S-2080 As-built	Oct. 2019	PR



The Corporation  
 of the  
 City of Windsor  
 Engineering – Infrastructure & Geomatics

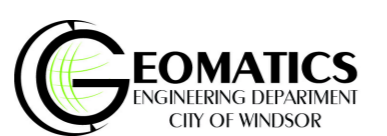

# SEWER ATLAS

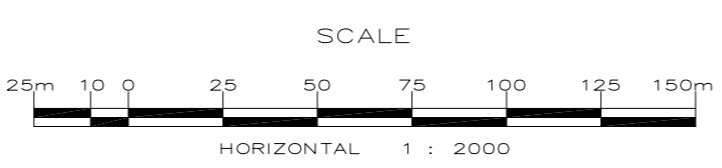

**Legend**

- SANITARY SEWER (Red dashed line)
- STORM SEWER (Blue dashed line)
- COMBINED SEWER (Green dashed line)
- PRIVATE SEWER (Purple dashed line)
- SANITARY PROPOSED OR AS BUILT INFO N/A (Red dashed line with 'P' or 'A')
- STORM (Blue dashed line with 'S')
- CULVERTS, CATCH BASINS AND OUTLETS (Yellow dashed line)
- GAS LINE (Orange dashed line)
- STEAM LINE (Light blue dashed line)
- HYDRO ONE (Light green dashed line)
- R.O.W. (Black dashed line)
- ASSESSMENT LOT (Black dashed line)
- HERB GRAY PKWY LIMITS (Yellow dashed line)

**Manhole Symbols**

- Sanitary: Circle with 'S' and number
- Storm: Circle with 'S' and number
- Combined: Circle with 'C' and number
- Proposed/As-Built: Circle with 'P' or 'A' and number

**Construction Drawing Number**

S-1000

L2	M2	N2
L3	M3	N3
L4	M4	N4