



NOTE:
 THE INFORMATION ON THIS PLAN IS COMPILED FROM VARIOUS SOURCES AND SHOULD BE VERIFIED PRIOR TO USE.
 LOCATIONS SHOWN ARE APPROXIMATE ONLY AND SHOULD BE VERIFIED IN THE FIELD PRIOR TO WORK COMMENCING.

Table of Revisions

M4			
Number	Revision	Date	By
0.	Added S-1879 and S-1956 As-Built	Sep 2014	MLR
	Added S-1945 As-Built	Sep 2014	MLR
	Added S-1995 Proposed	June 2015	MLR
	Added S-2016 Proposed	May 2016	MLR
	Added S-2042 Proposed	Sept 2017	NS
	Added S-1995 As-Built	Apr 2018	MLR
	Added S-2045 Proposed	Jan 2019	NS
	Added S-2066 Proposed	Mar 2019	NS





The Corporation
 of the
 City of Windsor

Engineering – Infrastructure & Geomatics



SEWER ATLAS

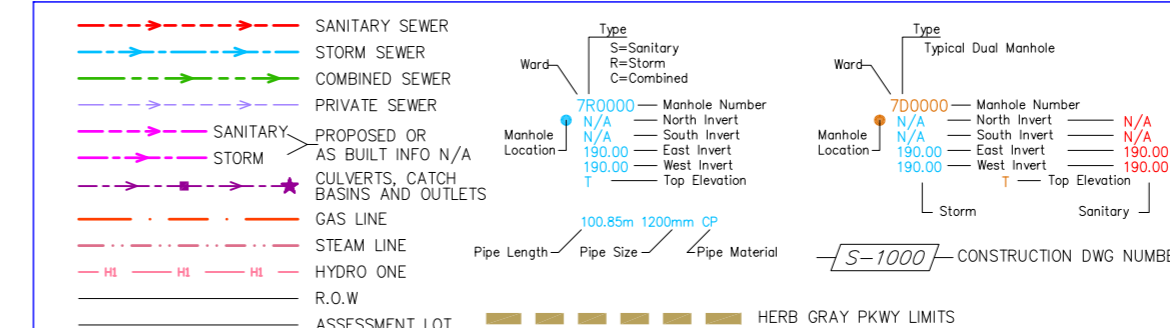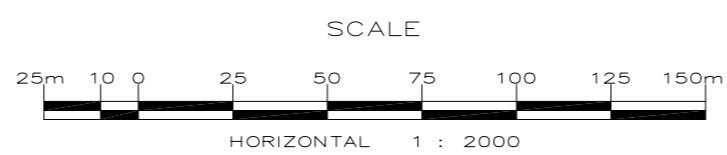

L3	M3	N3
L4	M4	N4
L5	M5	N5