


NOTE:
 THE INFORMATION ON THIS PLAN IS COMPILED FROM VARIOUS SOURCES AND SHOULD BE VERIFIED PRIOR TO USE.
 LOCATIONS SHOWN ARE APPROXIMATE ONLY AND SHOULD BE VERIFIED IN THE FIELD PRIOR TO WORK COMMENCING.

Table of Revisions


| Number | Revision | Date | By |
|--------|-----------------------|-----------|-------|
| 0. | Revised | June 2004 | WR/JC |
| | Revised | June 2005 | WR/JC |
| | Revised | June 2007 | WR |
| | Added S-1762 As-built | June 2013 | MLR |
| | Added S-1956 | Aug 2013 | MLR |
| | Added S-1914 As-built | June 2014 | MLR |
| | Added S-1945 As-built | Sep 2014 | MLR |
| | Revised | Oct. 2017 | NS |



The Corporation
 of the
 City of Windsor
 Engineering – Infrastructure & Geomatics

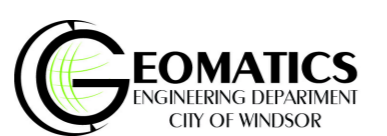

SEWER ATLAS

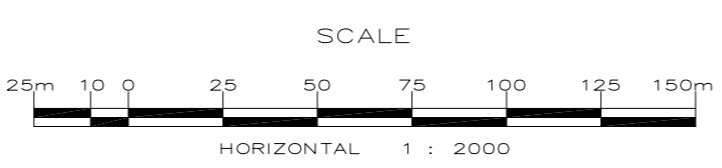

--- SANITARY SEWER
 --- STORM SEWER
 --- COMBINED SEWER
 --- PRIVATE SEWER
 --- SANITARY PROPOSED OR AS BUILT INFO N/A
 --- STORM CULVERTS, CATCH BASINS AND OUTLETS
 --- GAS LINE
 --- STEAM LINE
 --- HYDRO ONE
 --- R.O.W.
 --- ASSESSMENT LOT
 --- HERB GRAY PKWY LIMITS

Type
 S-Sanitary
 R-Storm
 C-Combined

Manhole Location
 700000 — Manhole Number
 N/A — North Invert
 N/A — South Invert
 190.00 — East Invert
 190.00 — West Invert
 T — Top Elevation

Pipe Length **Pipe Size** **Pipe Material**

Type
 700000 — Manhole Number
 N/A — North Invert
 N/A — South Invert
 190.00 — East Invert
 190.00 — West Invert
 T — Top Elevation

--- Storm
 --- Sanitary
 --- CONSTRUCTION DWG NUMBER (e.g., S-1000)

| | | |
|----|-----------|----|
| L4 | M4 | N4 |
| L5 | M5 | N5 |
| L6 | M6 | N6 |