

NOTE:
 THE INFORMATION ON THIS PLAN IS COMPILED FROM VARIOUS SOURCES AND SHOULD BE VERIFIED PRIOR TO USE.
 LOCATIONS SHOWN ARE APPROXIMATE ONLY AND SHOULD BE VERIFIED IN THE FIELD PRIOR TO WORK COMMENCING.

Table of Revisions

M7			
Number	Revision	Date	By
0.	Revised	01-04-19	
	Revised	03-07-04	
	Revised	Oct. 2003	WR/JC
	Revised	June 2004	WR/JC
	Revised	June 2005	WR/JC
	Revised	June 2007	WR
	Added S-2022 Meldrum Rd.	Oct. 2017	NS
	Added S-2022 As-built	July 2019	PR





The Corporation
 of the
 City of Windsor

Engineering – Infrastructure & Geomatics



SEWER ATLAS

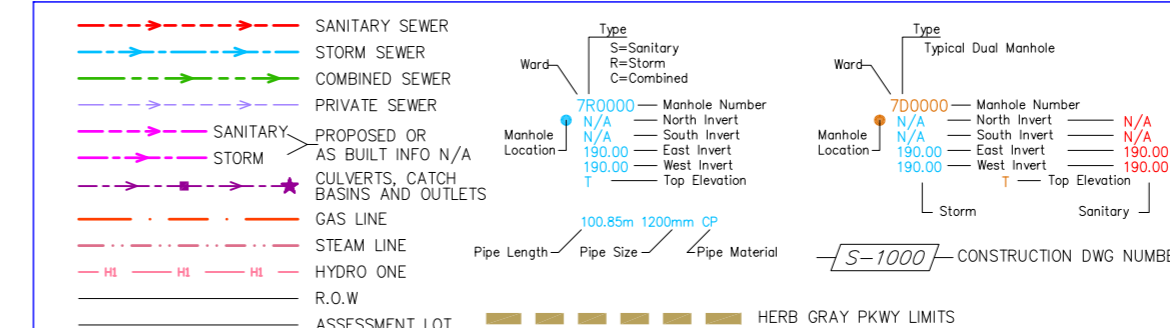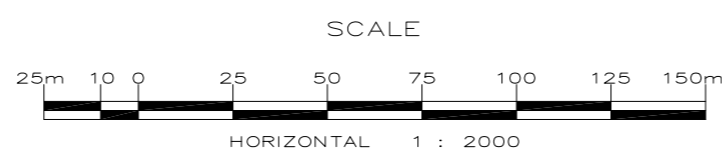

L6	M6	N6
L7	M7	N7
L8	M8	N8