

NOTE:
 THE INFORMATION ON THIS PLAN IS COMPILED FROM VARIOUS SOURCES AND SHOULD BE VERIFIED PRIOR TO USE.
 LOCATIONS SHOWN ARE APPROXIMATE ONLY AND SHOULD BE VERIFIED IN THE FIELD PRIOR TO WORK COMMENCING.

Table of Revisions

N13			
Number	Revision	Date	By
0.	Revised	Oct. 2003	WR/JC
	Revised	June 2004	WR/JC
	Revised	June 2005	WR/JC
	Revised	Nov 2006	WR/JC
	Revised	June 2007	WR
	Added S-1849 As-builts	Jan 2009	MLR
	Added S-1959 As-builts for Phase 3A-2	July 2013	MLR
	Added S-1959 As-builts for Phase 3C	July 2014	MLR




The Corporation
 of the
 City of Windsor

Engineering – Infrastructure & Geomatics



SEWER ATLAS

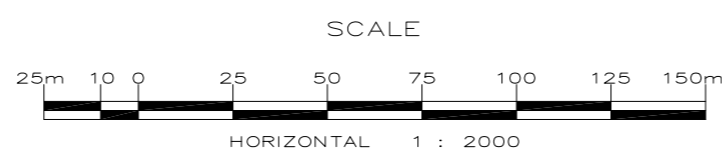

Legend

- SANITARY SEWER (Blue dashed line)
- STORM SEWER (Red dashed line)
- COMBINED SEWER (Green dashed line)
- PRIVATE SEWER (Yellow dashed line)
- SANITARY PROPOSED OR AS BUILT INFO N/A (Blue dashed line with 'P')
- STORM PROPOSED OR AS BUILT INFO N/A (Red dashed line with 'P')
- CULVERTS, CATCH BASINS AND OUTLETS (Star symbol)
- GAS LINE (Orange dashed line)
- STEAM LINE (Purple dashed line)
- HYDRO ONE (Blue dashed line with 'H')
- R.O.W. (Black dashed line)
- ASSESSMENT LOT (Black dashed line)
- HERB GRAY PKWY LIMITS (Yellow dashed line)

Manhole Symbols

- Type: S-Sanitary, R-Storm, C-Combined
- Manhole Location: 7R00000 - Manhole Number, N/A - North Invert, N/A - South Invert, N/A - East Invert, N/A - West Invert, T - Top Elevation
- Pipe Length: 100.85m, 1200mm CP
- Pipe Size: 100.85m, 1200mm CP
- Pipe Material: 100.85m, 1200mm CP

Typical Dual Manhole

- Type: 7R00000 - Manhole Number, N/A - North Invert, N/A - South Invert, N/A - East Invert, N/A - West Invert, T - Top Elevation
- Storm
- Sanitary

CONSTRUCTION DWG NUMBER: S-1000

M12	N12	O12
M13	N13	O13
M14	N14	O14