


NOTE:
 THE INFORMATION ON THIS PLAN IS COMPILED FROM VARIOUS SOURCES AND SHOULD BE VERIFIED PRIOR TO USE.
 LOCATIONS SHOWN ARE APPROXIMATE ONLY AND SHOULD BE VERIFIED IN THE FIELD PRIOR TO WORK COMMENCING.

Table of Revisions


N14			
Number	Revision	Date	By
0.	Revised	NOV. 2006	WR/JC
	Revised	June 2007	MLR
	Added S-1849 As-builts	Jan 2009	MLR
	Added P-1947 As-builts	Jan 2013	MLR
	Added S-1959 As-builts for Phase 3A-2	July 2013	MLR
	Added S-1959 As-builts for Phase 3C	July 2014	MLR
	Added S-2037 As-builts for Phase 3D	June 2016	MLR
	Added S-2049 As-built	Oct. 2018	NS



The Corporation
 of the
 City of Windsor
 Engineering – Infrastructure & Geomatics

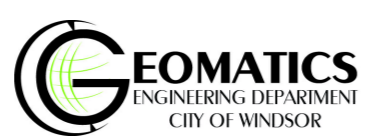

SEWER ATLAS

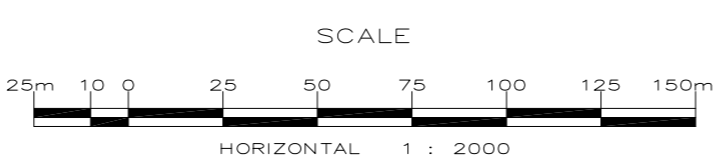

Legend

- SANITARY SEWER (Red dashed line)
- STORM SEWER (Blue dashed line)
- COMBINED SEWER (Green dashed line)
- PRIVATE SEWER (Purple dashed line)
- SANITARY AS BUILT INFO (Red solid line)
- STORM AS BUILT INFO (Blue solid line)
- CULVERTS, CATCH BASINS AND OUTLETS (Yellow dashed line)
- GAS LINE (Orange dashed line)
- STEAM LINE (Black dashed line)
- HYDRO ONE (Black dashed line)
- R.O.W. (Black dashed line)
- ASSESSMENT LOT (Black dashed line)
- HERB GRAY PKWY LIMITS (Black dashed line)

Manhole Location

- Sanitary: 7R0000 (N/A), 7S0000 (N/A)
- Storm: 7R0000 (N/A), 7S0000 (N/A)
- Combined: 7R0000 (N/A), 7S0000 (N/A)
- Private: 7R0000 (N/A), 7S0000 (N/A)
- Proposed: 7R0000 (N/A), 7S0000 (N/A)
- As-built: 7R0000 (N/A), 7S0000 (N/A)

Typical Dual Manhole

- Sanitary: 7R0000 (N/A), 7S0000 (N/A)
- Storm: 7R0000 (N/A), 7S0000 (N/A)
- Combined: 7R0000 (N/A), 7S0000 (N/A)
- Private: 7R0000 (N/A), 7S0000 (N/A)
- Proposed: 7R0000 (N/A), 7S0000 (N/A)
- As-built: 7R0000 (N/A), 7S0000 (N/A)

Construction DWG Number

- S-1000

M13	N13	O13
M14	N14	O14
M15	N15	O15