
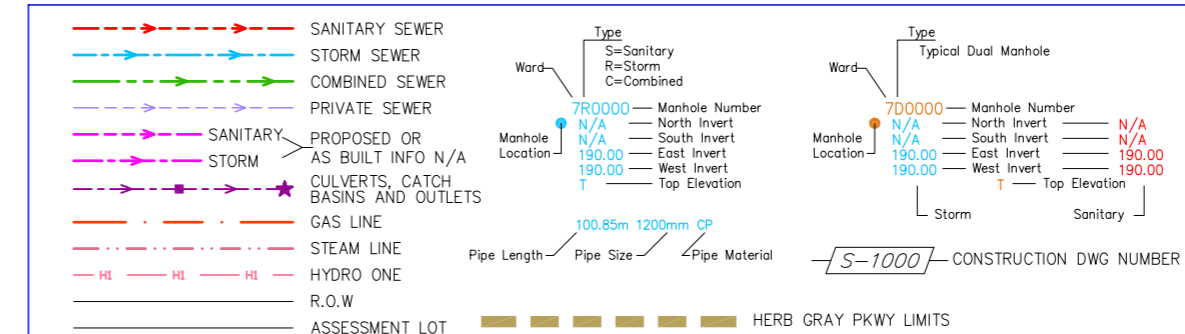


NOTE:
 THE INFORMATION ON THIS PLAN IS COMPILED FROM VARIOUS SOURCES AND SHOULD BE VERIFIED PRIOR TO USE.
 LOCATIONS SHOWN ARE APPROXIMATE ONLY AND SHOULD BE VERIFIED IN THE FIELD PRIOR TO WORK COMMENCING.

Table of Revisions

N15			
Number	Revision	Date	By
0.	Revised	01-04-19	
	Revised	03-07-04	
	Revised	Oct. 2003	WR/JC
	Revised	June 2004	WR/JC
	Revised	June 2005	WR/JC
	Revised	June 2007	WR
	Added S-1890 As-built	July 2010	MLR
	Added S-1964 As-built	June 2013	MLR

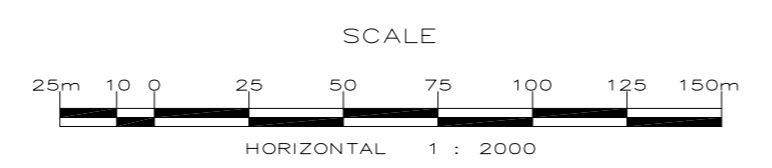

M14	N14	O14
M15	N15	O15
M16	N16	O16