

NOTE:  
THE INFORMATION ON THIS PLAN IS COMPILED FROM VARIOUS SOURCES AND SHOULD BE VERIFIED PRIOR TO USE.  
LOCATIONS SHOWN ARE APPROXIMATE ONLY AND SHOULD BE VERIFIED IN THE FIELD PRIOR TO WORK COMMENCING.


Table of Revisions

Number	Revision	Date	By
0.	Revised	June 2005	WR/JC
	Revised	June 2007	WR
	Added S-1892 Proposed	Mar 2010	MLR
	Added S-1853 As-Built	Feb 2015	MLR
	Added S-2001	Sep 2015	MLR
	Added S-2002	Oct 2015	MLR
	Added S-2001 As Built	Jun 2016	MLR
	Revised	Nov. 2017	NS




The Corporation  
of the  
City of Windsor

Engineering – Infrastructure & Geomatics

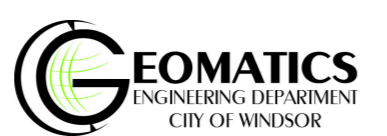

# SEWER ATLAS

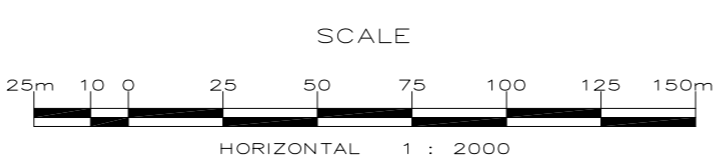

**Legend**

- SANITARY SEWER (Red dashed line)
- STORM SEWER (Blue dashed line)
- COMBINED SEWER (Green dashed line)
- PRIVATE SEWER (Purple dashed line)
- SANITARY PROPOSED OR AS BUILT INFO N/A (Red solid line)
- STORM PROPOSED OR AS BUILT INFO N/A (Blue solid line)
- CULVERTS, CATCH BASINS AND OUTLETS (Star symbol)
- GAS LINE (Orange dashed line)
- STEAM LINE (Yellow dashed line)
- HYDRO ONE (Light blue dashed line)
- R.O.W. (Black dashed line)
- ASSESSMENT LOT (Black solid line)
- HERB GRAY PKWY LIMITS (Yellow dashed line)

**Manhole Location**

- 700000 — Manhole Number
- N/A — North Invert
- N/A — South Invert
- 190.00 — East Invert
- 190.00 — West Invert
- T — Top Elevation

**Typical Dual Manhole**

- 700000 — Manhole Number
- N/A — North Invert
- N/A — South Invert
- 190.00 — East Invert
- 190.00 — West Invert
- T — Top Elevation

**Construction Drawing Number**

- S-1000

**Other Symbols**

- 100.85m 1200mm CP (Green dashed line)
- 100.85m 1200mm CP (Blue dashed line)
- 100.85m 1200mm CP (Red dashed line)

M2	N2	O2
M3	<b>N3</b>	O3
M4	N4	O4