


NOTE:
 THE INFORMATION ON THIS PLAN IS COMPILED FROM VARIOUS SOURCES AND SHOULD BE VERIFIED PRIOR TO USE.
 LOCATIONS SHOWN ARE APPROXIMATE ONLY AND SHOULD BE VERIFIED IN THE FIELD PRIOR TO WORK COMMENCING.

Table of Revisions


N4			
Number	Revision	Date	By
0.	Added S-2034 Proposed	Aug. 2017	NS
	Added S-2042 Proposed	Sept 2017	NS
	Added S-2045 Proposed	Jan 2019	NS
	Added S-2066 Proposed	Mar 2019	NS
	Added S-2065 Proposed	Mar 2019	NS
	Added S-1805 As-Built	APR 2019	NS
	Added S-2076 Proposed	Aug 2019	NS
	Added S-2034 As-Built	Oct. 2019	NS



The Corporation
 of the
 City of Windsor
 Engineering – Infrastructure & Geomatics

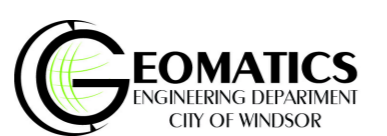

SEWER ATLAS

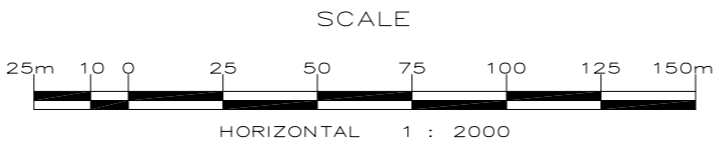

Legend

- SANITARY SEWER (Red dashed line)
- STORM SEWER (Blue dashed line)
- COMBINED SEWER (Green dashed line)
- PRIVATE SEWER (Purple dashed line)
- SANITARY PROPOSED OR AS BUILT INFO N/A (Red dashed line with 'P')
- STORM PROPOSED OR AS BUILT INFO N/A (Blue dashed line with 'S')
- CULVERTS, CATCH BASINS AND OUTLETS (Yellow star)
- GAS LINE (Orange dashed line)
- STEAM LINE (Red solid line)
- HYDRO ONE (Blue solid line)
- R.O.W. (Red solid line)
- ASSESSMENT LOT (Black dashed line)
- HERB GRAY PKWY LIMITS (Yellow dashed line)

Manhole Location

700000 — Manhole Number
 N/A — North Invert
 S/A — South Invert
 E/A — East Invert
 W/A — West Invert
 T — Top Elevation

Typical Dual Manhole

700000 — Manhole Number
 N/A — North Invert
 S/A — South Invert
 E/A — East Invert
 W/A — West Invert
 T — Top Elevation

Pipe Length | **Pipe Size** | **Pipe Material**

100.85m 1200mm CP
 S-1000 — CONSTRUCTION DWG NUMBER

M3	N3	O3
M4	N4	O4
M5	N5	O5