


NOTE:
 THE INFORMATION ON THIS PLAN IS COMPILED FROM VARIOUS SOURCES AND SHOULD BE VERIFIED PRIOR TO USE.
 LOCATIONS SHOWN ARE APPROXIMATE ONLY AND SHOULD BE VERIFIED IN THE FIELD PRIOR TO WORK COMMENCING.

Table of Revisions


Number	Revision	Date	By
0.	Added S-1905	June 2013	MLR
	Added S-1623 As-Built	Nov 2014	MLR
	Added S-2035 Norman Rd.	July 2017	NS
	Added S-2052 Proposed	Dec 2018	NS
	Added S-2052 As-Built	Feb 2019	NS
	Added S-1905 As-Built	Mar. 2019	NS
	Added S-2065 Proposed	Mar 2019	NS
	Added S-1905 As-Built	APR 2019	NS



The Corporation
 of the
 City of Windsor
 Engineering – Infrastructure & Geomatics

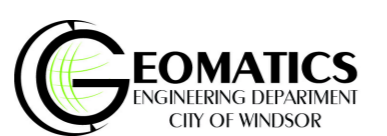

SEWER ATLAS

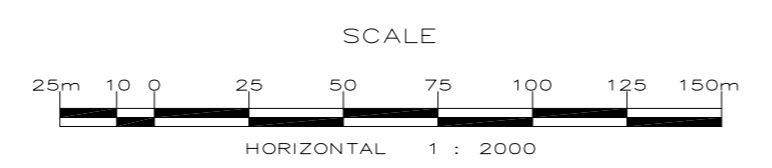

Legend

- SANITARY SEWER (Red dashed line)
- STORM SEWER (Blue dashed line)
- COMBINED SEWER (Green dashed line)
- PRIVATE SEWER (Purple dashed line)
- SANITARY PROPOSED OR AS BUILT INFO N/A (Red dashed line with 'N/A' label)
- STORM (Blue dashed line with 'S' label)
- CULVERTS, CATCH BASINS AND OUTLETS (Yellow dashed line)
- GAS LINE (Orange dashed line)
- STEAM LINE (Light blue dashed line)
- HYDRO ONE (Light green dashed line)
- R.O.W. (Red dashed line)
- ASSESSMENT LOT (Black dashed line)
- HERB GRAY PKWY LIMITS (Yellow dashed line)

Manhole Information

Ward: 7R00000 - Manhole Number
 Manhole Location: N/A, South Invert, East Invert, Top Elevation

Typical Dual Manhole

Ward: 7D00000 - Manhole Number
 Manhole Location: N/A, North Invert, South Invert, East Invert, Top Elevation

Construction DWG Number
 S-1000

M4	N4	O4
M5	N5	O5
M6	N6	O6