


NOTE:  
 THE INFORMATION ON THIS PLAN IS COMPILED FROM VARIOUS SOURCES AND SHOULD BE VERIFIED PRIOR TO USE.  
 LOCATIONS SHOWN ARE APPROXIMATE ONLY AND SHOULD BE VERIFIED IN THE FIELD PRIOR TO WORK COMMENCING.

Table of Revisions


Number	Revision	Date	By
0.	Revised	June 2004	WR/JC
	Revised	June 2005	WR/JC
	Revised	June 2007	WR/JC
	Added S-1623 As-built	Nov 2014	MLR
	Added S-1992 As-built	Jan 2016	MLR
	Revised	Nov. 2017	NS
	Added S-2068 Proposed	Mar. 2019	NS
	Added S-2080 As-Built	Oct 2019	PR



The Corporation  
 of the  
 City of Windsor  
 Engineering – Infrastructure & Geomatics

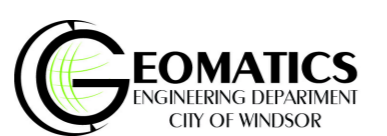

# SEWER ATLAS

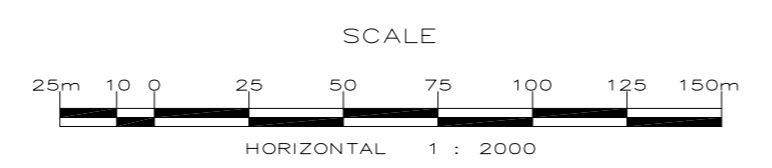

**Legend**

- SANITARY SEWER (Blue dashed line)
- STORM SEWER (Green dashed line)
- COMBINED SEWER (Red dashed line)
- PRIVATE SEWER (Purple dashed line)
- SANITARY PROPOSED OR AS BUILT INFO N/A (Blue dashed line with dots)
- STORM (Green dashed line with dots)
- CULVERTS, CATCH BASINS AND OUTLETS (Yellow star)
- GAS LINE (Orange dashed line)
- STEAM LINE (Red dashed line)
- HYDRO ONE (Blue dashed line)
- R.O.W. (Red dashed line)
- ASSESSMENT LOT (Yellow outline)
- HERB GRAY PKWY LIMITS (Yellow dashed line)

**Manhole Symbols**

- Sanitary: Blue circle with 'S' and number
- Storm: Green circle with 'S' and number
- Combined: Red circle with 'S' and number
- Private: Purple circle with 'S' and number
- Proposed/As-Built: Blue circle with 'S' and number
- Catch Basin: Yellow star

**Construction Drawing Number**

S-1000

M5	N5	O5
M6	<b>N6</b>	O6
M7	N7	O7