


NOTE:
 THE INFORMATION ON THIS PLAN IS COMPILED FROM VARIOUS SOURCES AND SHOULD BE VERIFIED PRIOR TO USE.
 LOCATIONS SHOWN ARE APPROXIMATE ONLY AND SHOULD BE VERIFIED IN THE FIELD PRIOR TO WORK COMMENCING.

Table of Revisions


P7				
Number	Revision	Date	By	
0.	Revised	Oct. 2003	WR	JC
	Revised	June 2004	WR	JC
	Revised	June 2005	WR	JC
	Revised	June 2007	WR	
	Added S-1895 As Built	June 2014	MLR	
	Added S-1982 Proposed	May 2015	MLR	
	Added S-1861 As Built	Dec 2015	MLR	
	Added S-1982 As Built	Nov 2016	MLR	



The Corporation
 of the
 City of Windsor
 Engineering – Infrastructure & Geomatics

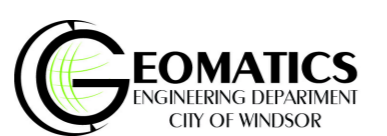

SEWER ATLAS

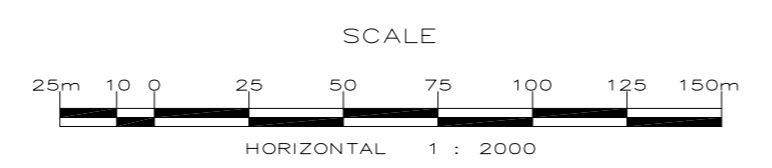

Legend

- SANITARY SEWER (Red dashed line)
- STORM SEWER (Blue dashed line)
- COMBINED SEWER (Green dashed line)
- PRIVATE SEWER (Purple dashed line)
- PROPOSED OR AS BUILT INFO (Yellow dashed line)
- SANITARY STORM (Blue dashed line with star)
- CULVERTS, CATCH BASINS AND OUTLETS (Star symbol)
- GAS LINE (Red solid line)
- STEAM LINE (Blue solid line)
- HYDRO ONE (Green solid line)
- R.O.W. (Red solid line)
- ASSESSMENT LOT (Black outline)
- HERB GRAY PKWY LIMITS (Yellow dashed line)

Manhole Location

Type: S-Sanitary, R-Storm, C-Combined
 7R0000 - Manhole Number
 N/A - North Invert
 S - South Invert
 E - East Invert
 W - West Invert
 T - Top Elevation

Typical Dual Manhole

7R0000 - Manhole Number
 N/A - North Invert
 S - South Invert
 E - East Invert
 W - West Invert
 T - Top Elevation

Pipe Length | Pipe Size | Pipe Material
 S-1000 CONSTRUCTION DWG NUMBER

06	P6	Q6
07	P7	Q7
08	P8	Q8