
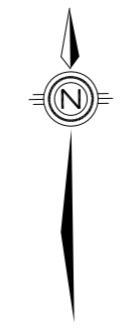


NOTE:  
 THE INFORMATION ON THIS PLAN IS COMPILED FROM VARIOUS SOURCES AND SHOULD BE VERIFIED PRIOR TO USE.  
 LOCATIONS SHOWN ARE APPROXIMATE ONLY AND SHOULD BE VERIFIED IN THE FIELD PRIOR TO WORK COMMENCING.

Table of Revisions

Q11			
Number	Revision	Date	By
0.	Revised	Sept/2003	
	Revised	Oct. 2003	WR/JC
	Revised	June 2004	WR/JC
	Revised	June 2005	WR/JC
	Revised	June 2007	WR
	Added S-1884 As-built	June 2011	MLR

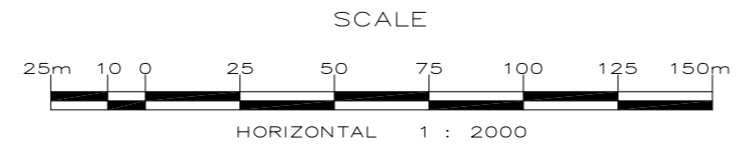

**Legend**

- SANITARY SEWER (Red dashed line)
- STORM SEWER (Blue dashed line)
- COMBINED SEWER (Green dashed line)
- PRIVATE SEWER (Purple dashed line)
- SANITARY PROPOSED OR AS BUILT INFO N/A (Red solid line)
- STORM AS BUILT INFO N/A (Blue solid line)
- CULVERTS, CATCH BASINS AND OUTLETS (Black dashed line)
- GAS LINE (Orange solid line)
- STEAM LINE (Yellow solid line)
- HYDRO ONE (Light Blue solid line)
- R.O.W (Black solid line)
- ASSESSMENT LOT (Black outline)
- HERB GRAY PKWY LIMITS (Yellow dashed line)

**Manhole Location**

- Type: S=Sanitary, R=Storm, C=Combined
- Manhole Number: 7R0000
- Location: North Invert, South Invert, East Invert, West Invert, Top Elevation

**Typical Dual Manhole**

- Type: S=Sanitary, R=Storm, C=Combined
- Manhole Number: 7R0000
- Location: North Invert, South Invert, East Invert, West Invert, Top Elevation

**Construction Details**

- 100.85m 1200mm CP (Red dashed line)
- 100.00m 1200mm CP (Blue dashed line)
- 100.00m 1200mm CP (Green dashed line)
- 100.00m 1200mm CP (Purple dashed line)
- 100.00m 1200mm CP (Black dashed line)
- 100.00m 1200mm CP (Orange solid line)
- 100.00m 1200mm CP (Yellow solid line)
- 100.00m 1200mm CP (Light Blue solid line)
- 100.00m 1200mm CP (Black solid line)

P10	Q10	R10
P11	<b>Q11</b>	R11
P12	Q12	R12