

NOTE:
 THE INFORMATION ON THIS PLAN IS COMPILED FROM VARIOUS SOURCES AND SHOULD BE VERIFIED PRIOR TO USE.
 LOCATIONS SHOWN ARE APPROXIMATE ONLY AND SHOULD BE VERIFIED IN THE FIELD PRIOR TO WORK COMMENCING.


Table of Revisions

| R2 | | | |
|--------|---|-----------|-----|
| Number | Revision | Date | By |
| | Revised | Oct 2008 | JM |
| | Added S-1894 Proposed | Apr 2010 | MLR |
| | Revised Little River Treatment Plant Area | Nov 2010 | MLR |
| | Added S-1894 As-built | Jan 2011 | MLR |
| | Added S-1872 and P-1917 As-builts | Jan 2012 | MLR |
| | Added S-1625 As-builts | Mar 2012 | MLR |
| | Revised | Nov. 2017 | NS |
| | Added S-2051 Proposed | Dec. 2018 | NS |




The Corporation
 of the
 City of Windsor

Engineering – Infrastructure & Geomatics

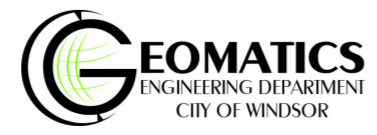

SEWER ATLAS

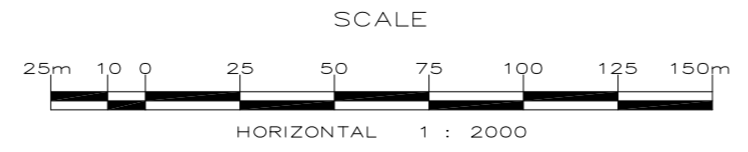

Legend

- SANITARY SEWER (Red dashed line)
- STORM SEWER (Blue dashed line)
- COMBINED SEWER (Green dashed line)
- PRIVATE SEWER (Purple dashed line)
- SANITARY PROPOSED OR AS BUILT INFO N/A (Red solid line)
- STORM (Blue solid line)
- CULVERTS, CATCH BASINS AND OUTLETS (Star symbol)
- GAS LINE (Orange solid line)
- STEAM LINE (Yellow solid line)
- HYDRO ONE (Light blue solid line)
- R.O.W. (Red dashed line)
- ASSESSMENT LOT (Black dashed line)
- HERB GRAY PKWY LIMITS (Yellow dashed line)

Manhole Location

- Type: S=Sanitary, R=Storm, C=Combined
- Manhole Number: 700000
- Location: North Invert, South Invert, East Invert, West Invert, Top Elevation

Pipe Length

- 100.85m 1200mm CP
- 150.00m 1000mm CP
- 150.00m 1500mm CP
- 150.00m 1800mm CP
- 150.00m 2400mm CP

Construction DWG Number

- S-1000

| | | |
|----|-----------|----|
| Q1 | R1 | S1 |
| Q2 | R2 | S2 |
| Q3 | R3 | S3 |