

NOTE:
 THE INFORMATION ON THIS PLAN IS COMPILED FROM VARIOUS SOURCES AND SHOULD BE VERIFIED PRIOR TO USE.
 LOCATIONS SHOWN ARE APPROXIMATE ONLY AND SHOULD BE VERIFIED IN THE FIELD PRIOR TO WORK COMMENCING.

Table of Revisions

R4			
Number	Revision	Date	By
S-1874	As-built	June 2010	MLR
	Added S-1882 As-built	Jan 2011	MLR
	Added S-1759 As-built	May 2011	MLR
	Added S-1920 As-built	Nov 2011	MLR
	Added S-1943 As-built	Feb 2013	MLR
	Added S-2012 As-built	July 2016	MLR
	Revised	Dec. 2017	NS
	Added S-2058 As-built	Apr. 2019	PR




The Corporation
 of the
 City of Windsor

Engineering – Infrastructure & Geomatics



SEWER ATLAS

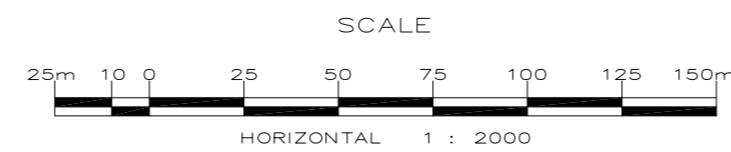

Legend

- SANITARY SEWER (Red dashed line)
- STORM SEWER (Blue dashed line)
- COMBINED SEWER (Green dashed line)
- PRIVATE SEWER (Purple dashed line)
- SANITARY PROPOSED OR AS BUILT INFO N/A (Red solid line)
- STORM (Blue solid line)
- CULVERTS, CATCH BASINS AND OUTLETS (Yellow dashed line)
- GAS LINE (Orange solid line)
- STEAM LINE (Black solid line)
- HYDRO ONE (Black solid line)
- R.O.W. (Black solid line)
- ASSESSMENT LOT (Black solid line)
- HERB GRAY PKWY LIMITS (Black dashed line)

Manhole Symbols

- Type: S=Sanitary, C=Combined, P=Private
- Manhole Location: 7R00000 - Manhole Number, N/A - North Invert, S/A - South Invert, 190.00 - East Invert, 190.00 - West Invert, 190.00 - Top Elevation
- Typical Dual Manhole: 7R00000 - Manhole Number, N/A - North Invert, N/A - South Invert, 190.00 - East Invert, 190.00 - West Invert, 190.00 - Top Elevation

Other Symbols

- Sturm (Blue dashed line)
- Sanitary (Red dashed line)
- Construction DWG Number: S-1000
- Pipe Length, Pipe Size, Pipe Material

Q3	R3	S3
Q4	R4	S4
Q5	R5	S5