

NOTE:
 THE INFORMATION ON THIS PLAN IS COMPILED FROM VARIOUS SOURCES AND SHOULD BE VERIFIED PRIOR TO USE.
 LOCATIONS SHOWN ARE APPROXIMATE ONLY AND SHOULD BE VERIFIED IN THE FIELD PRIOR TO WORK COMMENCING.


Table of Revisions

Number	Revision	Date	By
0.	Revised	Oct. 2003	WR/JC
	Revised	June 2004	WR/JC
	Revised	June 2005	WR/JC
	Revised	June 2007	WR
	Added S-1874 & S-1875 Proposed	Sep 2009	MLR
	Added S-1874 As-built	June 2010	MLR
	Added S-1920 As-built	Nov 2011	MLR
	Added S-1943 As-built	Feb 2013	MLR



Q4	R4	S4
Q5	R5	S5
Q6	R6	S6



The Corporation
 of the
 City of Windsor
 Engineering – Infrastructure & Geomatics

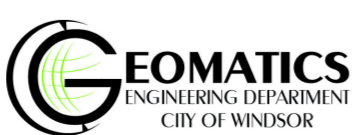

SEWER ATLAS

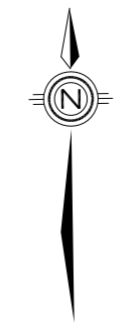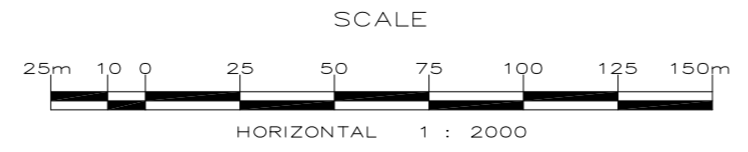

Legend for Sewer Lines and Manholes:

- SANITARY SEWER (Red dashed line)
- STORM SEWER (Blue dashed line)
- COMBINED SEWER (Green dashed line)
- PRIVATE SEWER (Purple dashed line)
- SANITARY PROPOSED OR AS BUILT INFO N/A (Red solid line)
- STORM (Blue solid line)
- CULVERTS, CATCH BASINS AND OUTLETS (Yellow dashed line)
- GAS LINE (Orange dashed line)
- STEAM LINE (Black dashed line)
- HYDRO ONE (Black solid line)
- R.O.W. (Black solid line)
- ASSESSMENT LOT (Black solid line)
- HERB GRAY PKWY LIMITS (Black dashed line)

Manhole Information:

- Type: S=Sanitary, R=Storm, C=Combined
- Manhole Number: 7R00000
- Location: North Invert, South Invert, East Invert, West Invert, Top Elevation
- Manhole Size: 100.00mm, 150.00mm, 200.00mm
- Manhole Material: CP (Cast Polypropylene)
- Construction DWG Number: S-1000