

NOTE:
 THE INFORMATION ON THIS PLAN IS COMPILED FROM VARIOUS SOURCES AND SHOULD BE VERIFIED PRIOR TO USE.
 LOCATIONS SHOWN ARE APPROXIMATE ONLY AND SHOULD BE VERIFIED IN THE FIELD PRIOR TO WORK COMMENCING.

Table of Revisions

R6			
Number	Revision	Date	By
0.	Revised	Sept/2003	WR/JC
	Revised	Oct. 2003	WR/JC
	Revised	June 2004	WR/JC
	Revised	June 2005	WR/JC
	Revised	June 2007	WR
	Revised To Show Edge of Pavement 2006	July 2007	WR
	As-Builts for S-1876 - Ruth Rd	Jan 2010	MLR
	Revised	Dec. 2017	NS





The Corporation
 of the
 City of Windsor

Engineering – Infrastructure & Geomatics



SEWER ATLAS

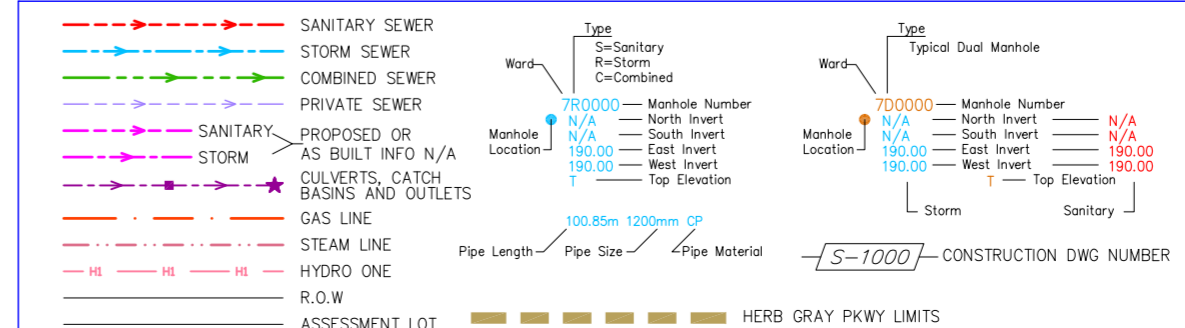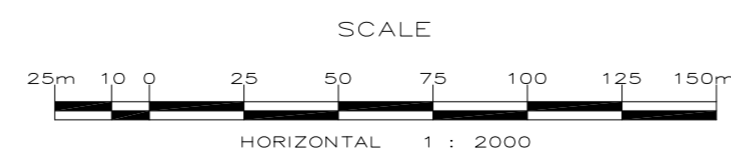

Q5	R5	S5
Q6	R6	S6
Q7	R7	S7