

NOTE:
 THE INFORMATION ON THIS PLAN IS COMPILED FROM VARIOUS SOURCES AND SHOULD BE VERIFIED PRIOR TO USE.
 LOCATIONS SHOWN ARE APPROXIMATE ONLY AND SHOULD BE VERIFIED IN THE FIELD PRIOR TO WORK COMMENCING.

Table of Revisions


S10			
Number	Revision	Date	By
0.	Revised	Sept/2003	
	Revised	Oct. 2003	WR/JC
	Revised	June 2004	WR/JC
	Revised	June 2005	WR/JC
	Revised	June 2007	WR
	Added S-1888 - Proposed	Dec 2009	MLR
	Added S-1888 As-built	July 2011	MLR



The Corporation
 of the
 City of Windsor
 Engineering – Infrastructure & Geomatics



SEWER ATLAS

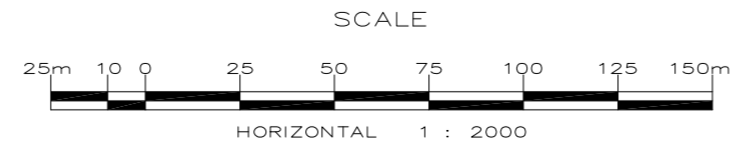

Legend

- SANITARY SEWER
- STORM SEWER
- COMBINED SEWER
- PRIVATE SEWER
- SANITARY PROPOSED OR AS BUILT INFO N/A
- STORM PROPOSED OR AS BUILT INFO N/A
- CULVERTS, CATCH BASINS AND OUTLETS
- GAS LINE
- STEAM LINE
- HYDRO ONE
- R.O.W.
- ASSESSMENT LOT
- HERB GRAY PKWY LIMITS

Manhole Location

- Type: S=Sanitary, Re=Storm, C=Combined
- Manhole Number: 7R0000
- Location: N/A, North Invert, South Invert, East Invert, West Invert, Top Elevation

Typical Dual Manhole

- Type: S=Sanitary, Re=Storm, C=Combined
- Manhole Number: 7R0000
- Location: N/A, North Invert, South Invert, East Invert, West Invert, Top Elevation

Construction DWG Number

- S-1000

R9	S9	T9
R10	S10	T10
R11	S11	T11