

NOTE:
 THE INFORMATION ON THIS PLAN IS COMPILED FROM VARIOUS SOURCES AND SHOULD BE VERIFIED PRIOR TO USE.
 LOCATIONS SHOWN ARE APPROXIMATE ONLY AND SHOULD BE VERIFIED IN THE FIELD PRIOR TO WORK COMMENCING.

Table of Revisions

S2			
Number	Revision	Date	By
0.	Revised	Oct. 2003	WR/JC
	Revised	June 2004	WR/JC
	Revised	June 2005	WR/JC
	Revised	June 2007	WR
	Added P-1935 As-built	Nov. 2011	MLR
	Revised	Dec. 2017	NS
	Added S-2043 Proposed	Jan. 2018	NS
	Added S-2043 As-built	Mar. 2018	NS





The Corporation
 of the
 City of Windsor

Engineering – Infrastructure & Geomatics



SEWER ATLAS

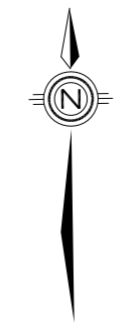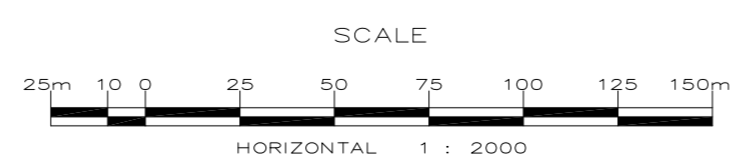

Legend

- SANITARY SEWER (Red dashed line)
- STORM SEWER (Blue dashed line)
- COMBINED SEWER (Green dashed line)
- PRIVATE SEWER (Purple dashed line)
- SANITARY PROPOSED OR AS BUILT INFO N/A (Red solid line)
- STORM (Blue solid line)
- CULVERTS, CATCH BASINS AND OUTLETS (Star symbol)
- GAS LINE (Orange solid line)
- STEAM LINE (Yellow solid line)
- HYDRO ONE (Light blue solid line)
- R.O.W. (Black dashed line)
- ASSESSMENT LOT (Black outline)
- HERB GRAY PKWY LIMITS (Yellow dashed line)

Manhole

- Type: S=Sanitary, R=Storm, C=Combined
- Manhole Location: 7R0000
- Manhole Number: 7R0000
- North Invert: N/A
- South Invert: N/A
- East Invert: 190.00
- West Invert: 190.00
- Top Elevation: 190.00

Typical Dual Manhole

- Type: S=Sanitary, R=Storm
- Manhole Location: 7R0000
- Manhole Number: 7R0000
- North Invert: N/A
- South Invert: N/A
- East Invert: 190.00
- West Invert: 190.00
- Top Elevation: 190.00

Other Symbols

- Pipe Length: 100.85m, 120.00m CP
- Pipe Size: 150mm, 200mm
- Pipe Material: S-1000
- CONSTRUCTION DWG NUMBER: S-1000

R1	S1	T1
R2	S2	T2
R3	S3	T3