


NOTE:
 THE INFORMATION ON THIS PLAN IS COMPILED FROM VARIOUS SOURCES AND SHOULD BE VERIFIED PRIOR TO USE.
 LOCATIONS SHOWN ARE APPROXIMATE ONLY AND SHOULD BE VERIFIED IN THE FIELD PRIOR TO WORK COMMENCING.

Table of Revisions



Number	Revision	Date	By
0.	Added S-2043 Proposed	Jan. 2018	NS
	Added S-2043 As-built	Mar. 2018	NS
	Added S-2074 Proposed	Sep. 2018	NS
	Added S-1978 As-built	Dec. 2018	PR
	Added S-2050 As-built	Jan. 2019	NS
	Added S-2070 As-built	Mar. 2019	NS
	Added S-2058 As-built	Apr. 2019	PR
	Added S-2074 As-built	June 2019	PR



The Corporation
 of the
 City of Windsor
 Engineering – Infrastructure & Geomatics

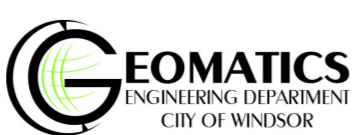

SEWER ATLAS

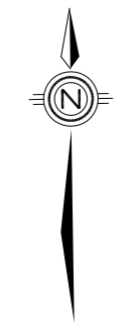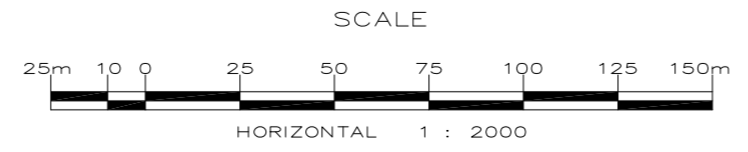

Legend

- SANITARY SEWER (Red dashed line)
- STORM SEWER (Blue dashed line)
- COMBINED SEWER (Green dashed line)
- PRIVATE SEWER (Purple dashed line)
- SANITARY AS BUILT INFO N/A (Red solid line)
- STORM AS BUILT INFO N/A (Blue solid line)
- CULVERTS, CATCH BASINS AND OUTLETS (Yellow dashed line)
- GAS LINE (Orange dashed line)
- STEAM LINE (Black dashed line)
- HYDRO ONE (Black solid line)
- R.O.W. (Black solid line)
- ASSESSMENT LOT (Black solid line)
- HERB GRAY PKWY LIMITS (Black solid line)

Manhole Symbols

- Type: S=Sanitary, R=Storm, C=Combined
- Manhole Location: 7R00000 - Manhole Number, North Invert, South Invert, East Invert, West Invert, Top Elevation
- Type: Typical Dual Manhole
- Manhole Location: 7R00000 - Manhole Number, North Invert, South Invert, East Invert, West Invert, Top Elevation

Other Symbols

- Sturm
- Sanitary
- CONSTRUCTION DWG NUMBER: S-1000

R2	S2	T2
R3	S3	T3
R4	S4	T4