

NOTE:
 THE INFORMATION ON THIS PLAN IS COMPILED FROM VARIOUS SOURCES AND SHOULD BE VERIFIED PRIOR TO USE.
 LOCATIONS SHOWN ARE APPROXIMATE ONLY AND SHOULD BE VERIFIED IN THE FIELD PRIOR TO WORK COMMENCING.

Table of Revisions

Number	Revision	Date	By
0.	Revised	June 2005	WR/JC
	Revised	July 2007	WR
	Revised To Show Edge of Pavement 2006	July 2007	WR
	As-builts for Katella Ave.	Nov 2007	MR
	As-builts for Luxury Ave. & Sturgeon St.	Dec 2007	MR
	Added S-1985 As-built	Dec. 2014	MLR
	Revised	Dec. 2017	NS
	Added S-2058 As-built	Apr. 2019	PR




The Corporation
 of the
 City of Windsor

Engineering – Infrastructure & Geomatics



SEWER ATLAS

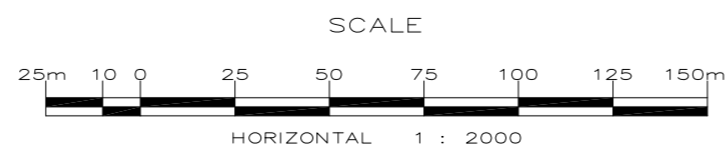

Legend

- SANITARY SEWER (Red dashed line)
- STORM SEWER (Blue dashed line)
- COMBINED SEWER (Green dashed line)
- PRIVATE SEWER (Purple dashed line)
- SANITARY AS BUILT (Red solid line)
- STORM AS BUILT (Blue solid line)
- CULVERTS, CATCH BASINS AND OUTLETS (Yellow dashed line)
- GAS LINE (Orange dashed line)
- STEAM LINE (Black dashed line)
- HYDRO ONE (Black dashed line)
- R.O.W. (Black dashed line)
- ASSESSMENT LOT (Black dashed line)
- HERB GRAY PKWY LIMITS (Black dashed line)

Manhole Symbols

- Sanitary Manhole: Circle with 'S' and number (e.g., S-1000)
- Storm Manhole: Circle with 'C' and number (e.g., C-1000)
- Combined Manhole: Circle with 'C' and number (e.g., C-1000)
- Typical Dual Manhole: Circle with 'S' and 'C' and number (e.g., S-C-1000)

Manhole Location

- North Invert: 100.00
- South Invert: 100.00
- East Invert: 100.00
- West Invert: 100.00
- Top Elevation: 100.00

Construction Drawing Number

S-1000

R3	S3	T3
R4	S4	T4
R5	S5	T5