

NOTE:
 THE INFORMATION ON THIS PLAN IS COMPILED FROM VARIOUS SOURCES AND SHOULD BE VERIFIED PRIOR TO USE.
 LOCATIONS SHOWN ARE APPROXIMATE ONLY AND SHOULD BE VERIFIED IN THE FIELD PRIOR TO WORK COMMENCING.

Table of Revisions


Number	Revision	Date	By
0.	Revised	Sept/2003	WR/JC
	Revised	Oct. 2003	WR/JC
	Revised	June 2004	WR/JC
	Revised	June 2005	WR/JC
	Revised	June 2007	WR
	Revised To Show Edge of Pavement 2006	July 2007	WR
	Springhollow as-builts	Jan 2008	PAJ
	Trunk Sanitary Sewer as-builts for Annexed Lands along CNR	Jan 2008	MLR



The Corporation
 of the
 City of Windsor
 Engineering – Infrastructure & Geomatics



SEWER ATLAS

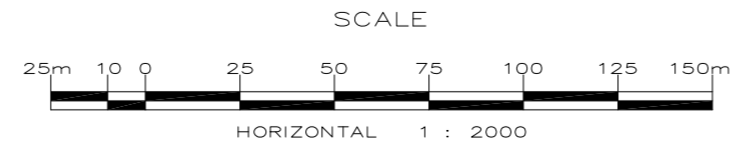

Legend

- SANITARY SEWER (Red dashed line)
- STORM SEWER (Blue dashed line)
- COMBINED SEWER (Green dashed line)
- PRIVATE SEWER (Purple dashed line)
- SANITARY PROPOSED OR AS BUILT INFO N/A (Red solid line)
- STORM (Blue solid line)
- CULVERTS, CATCH BASINS AND OUTLETS (Yellow dashed line)
- GAS LINE (Orange dashed line)
- STEAM LINE (Black dashed line)
- HYDRO ONE (Black solid line)
- R.O.W. (Black solid line)
- ASSESSMENT LOT (Black solid line)
- HERB GRAY PKWY LIMITS (Black dashed line)

Manhole Information

- Manhole Location: 7R00000 - Manhole Number
- Ward: S=Sanitary, R=Storm, C=Combined
- Manhole Location: 7S00000 - Manhole Number
- Ward: S=Sanitary, R=Storm, C=Combined
- Manhole Location: 7T00000 - Manhole Number
- Ward: S=Sanitary, R=Storm, C=Combined

Construction Drawing Number

S-1000

R4	S4	T4
R5	S5	T5
R6	S6	T6