

NOTE:
THE INFORMATION ON THIS PLAN IS COMPILED FROM VARIOUS SOURCES AND SHOULD BE VERIFIED PRIOR TO USE.
LOCATIONS SHOWN ARE APPROXIMATE ONLY AND SHOULD BE VERIFIED IN THE FIELD PRIOR TO WORK COMMENCING.

Table of Revisions

T4			
Number	Revision	Date	By
0.	Revised	June 2005	WR/JC
	Revised	July 2007	WR
	Revised To Show Edge of Pavement 2006	June 2007	WR
	Revised to show asphalt S-1413	April 2008	PJ
	Revised	Oct 2008	JM
	Added S-1963 As-Built	Jan 2014	MLR
	Added S-1988 As-Built	Nov 2014	MLR
	Added S-2004 As-built	Jul 2015	MLR





The Corporation
of the
City of Windsor

Engineering – Infrastructure & Geomatics



SEWER ATLAS

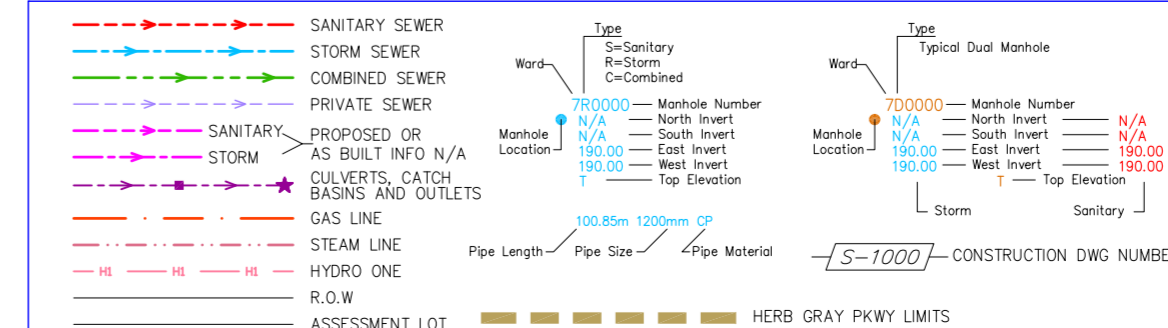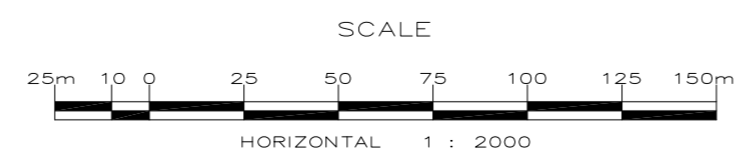

S3	T3	U3
S4	T4	U4
S5	T5	U5