
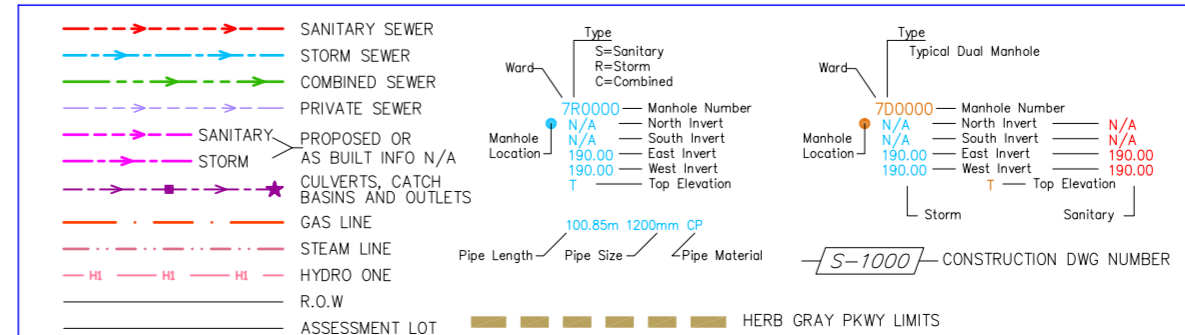


NOTE:  
 THE INFORMATION ON THIS PLAN IS COMPILED FROM VARIOUS SOURCES AND SHOULD BE VERIFIED PRIOR TO USE.  
 LOCATIONS SHOWN ARE APPROXIMATE ONLY AND SHOULD BE VERIFIED IN THE FIELD PRIOR TO WORK COMMENCING.

Table of Revisions

Number	Revision	Date	By
0.	Revised	June 2005	WR/JC
	Revised	July 2007	WR
	Revised to Show Edge of Pavement 2006	July 2007	WR
	As-builts for Banwell Sanitary Sewer	Nov 2007	MR
	Springhollow as-builts	Jan 2008	PJU
	Revised	Oct 2008	JM
	Added S-1963 As-Built	Jan 2014	MLR
	Added S-1988 As-Built	Nov 2014	MLR

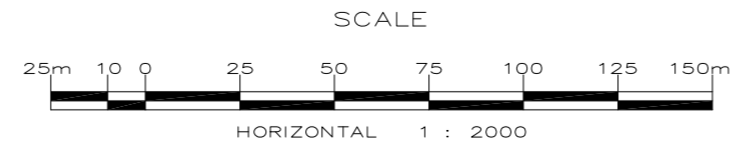

S4	T4	U4
S5	<b>T5</b>	U5
S6	T6	U6