

ARBOUR ST

BROUILLETTE CT

SOUTHFIELD DR

BORDER CRES

BANWELL RD

E C ROW EXPRESSWAY

NOTE:  
THE INFORMATION ON THIS PLAN IS COMPILED FROM VARIOUS SOURCES AND SHOULD BE VERIFIED PRIOR TO USE.  
LOCATIONS SHOWN ARE APPROXIMATE ONLY AND SHOULD BE VERIFIED IN THE FIELD PRIOR TO WORK COMMENCING.

Table of Revisions

T6			
Number	Revision	Date	By
0.	Revised	Sept/2003	
	Revised	Oct. 2003	WR/JC
	Revised	June 2004	WR/JC
	Revised	June 2005	WR/JC
	Revised	June 2007	WR
	Revised To Show Edge of Pavement 2006	July 2007	WR
	Added As-Builts for Banwell Sanitary Sewer	Nov 2007	MR
	Added S-2036 As-Builts	Sep 2016	MR





The Corporation  
of the  
City of Windsor

Engineering – Infrastructure & Geomatics



# SEWER ATLAS

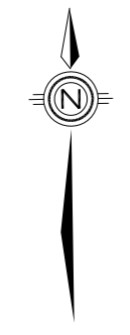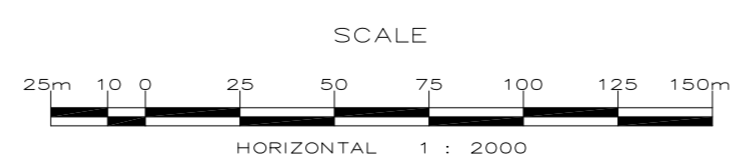

<ul style="list-style-type: none"> <li><span style="color: red;">---</span> SANITARY SEWER</li> <li><span style="color: blue;">---</span> STORM SEWER</li> <li><span style="color: green;">---</span> COMBINED SEWER</li> <li><span style="color: magenta;">---</span> PRIVATE SEWER</li> <li><span style="color: cyan;">---</span> SANITARY AS BUILT INFO N/A</li> <li><span style="color: yellow;">---</span> STORM AS BUILT INFO N/A</li> <li><span style="color: purple;">---</span> CULVERTS, CATCH BASINS AND OUTLETS</li> <li><span style="color: orange;">---</span> GAS LINE</li> <li><span style="color: brown;">---</span> STEAM LINE</li> <li><span style="color: pink;">---</span> HYDRO ONE</li> <li><span style="color: grey;">---</span> R.O.W</li> <li><span style="border: 1px solid black; display: inline-block; width: 10px; height: 10px;"></span> ASSESSMENT LOT</li> </ul>	<p>Type</p> <ul style="list-style-type: none"> <li>S=Sanitary</li> <li>Re=Storm</li> <li>C=Combined</li> </ul> <p>Manhole Location</p> <ul style="list-style-type: none"> <li>7R0000 - Manhole Number</li> <li>North Invert</li> <li>South Invert</li> <li>190.00 - East Invert</li> <li>190.00 - West Invert</li> <li>190.00 - Top Elevation</li> </ul> <p>Pipe Length</p> <ul style="list-style-type: none"> <li>100.85m 1200mm CP</li> <li>4 - Pipe Material</li> </ul>	<p>Type</p> <ul style="list-style-type: none"> <li>7R0000 - Manhole Number</li> <li>North Invert</li> <li>South Invert</li> <li>190.00 - East Invert</li> <li>190.00 - West Invert</li> <li>190.00 - Top Elevation</li> </ul> <p>Storm</p> <ul style="list-style-type: none"> <li>Sanitary</li> </ul>
--	--	---

S-1000 CONSTRUCTION DWG NUMBER

HERB GRAY PKWY LIMITS

S5	T5	U5
S6	T6	U6
S7	T7	U7