

NOTE:
 THE INFORMATION ON THIS PLAN IS COMPILED FROM VARIOUS SOURCES AND SHOULD BE VERIFIED PRIOR TO USE.
 LOCATIONS SHOWN ARE APPROXIMATE ONLY AND SHOULD BE VERIFIED IN THE FIELD PRIOR TO WORK COMMENCING.

Table of Revisions


T8			
Number	Revision	Date	By
0.	Revised	Sept/2003	
	Revised	Oct. 2003	WR/JC
	Revised	June 2004	WR/JC
	Revised	June 2005	WR/JC
	Revised	June 2007	WR
	Added S-1902 As-built	Apr 2011	MR



The Corporation
 of the
 City of Windsor
 Engineering – Infrastructure & Geomatics



SEWER ATLAS

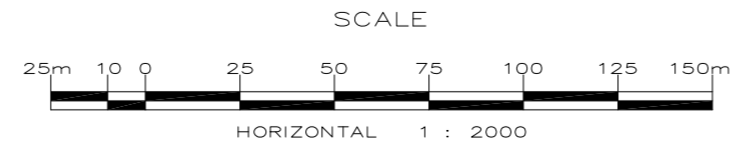

- SANITARY SEWER
- STORM SEWER
- COMBINED SEWER
- PRIVATE SEWER
- SANITARY PROPOSED OR AS BUILT INFO N/A
- STORM
- CULVERTS, CATCH BASINS AND OUTLETS
- GAS LINE
- STEAM LINE
- HYDRO ONE
- R.O.W
- ASSESSMENT LOT

Manhole Location

- Type S=Sanitary
- Type Re=Storm
- Type C=Combined
- Manhole Number 7R0000
- North Invert N/A
- South Invert N/A
- East Invert 190.00
- West Invert 190.00
- Top Elevation 190.00

Storm

- 100.85m CP
- 1200mm CP

Sanitary

- 100.85m CP
- 1200mm CP

—S-1000— CONSTRUCTION DWG NUMBER

HERB GRAY PKWY LIMITS

S7	T7	U7
S8	T8	U8
S9	T9	U9