

NOTE:
 THE INFORMATION ON THIS PLAN IS COMPILED FROM VARIOUS SOURCES AND SHOULD BE VERIFIED PRIOR TO USE.
 LOCATIONS SHOWN ARE APPROXIMATE ONLY AND SHOULD BE VERIFIED IN THE FIELD PRIOR TO WORK COMMENCING.

Table of Revisions


F10				
Number	Revision	Date	By	
0.	Revised	01-04-19		
	Revised	03-04-14		
	Revised	Oct. 2003	WR/JC	
	Revised	June 2004	WR/JC	
	Revised	June 2005	WR/JC	
	Revised	June 2007	WR	
	Added As-built S-1867	Jan 2008	MR	
	Revised	Jan. 2018	NS	



The Corporation
 of the
 City of Windsor
 Engineering – Infrastructure & Geomatics



SEWER ATLAS

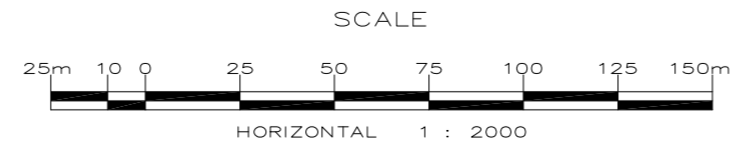

Legend

- SANITARY SEWER (Red dashed line)
- STORM SEWER (Blue dashed line)
- COMBINED SEWER (Green dashed line)
- PRIVATE SEWER (Purple dashed line)
- SANITARY PROPOSED OR AS BUILT INFO N/A (Red dashed line with dots)
- STORM (Blue dashed line with dots)
- CULVERTS, CATCH BASINS AND OUTLETS (Star symbol)
- GAS LINE (Orange dashed line)
- STEAM LINE (Yellow dashed line)
- HYDRO ONE (Light blue dashed line)
- R.O.W (Black dashed line)
- ASSESSMENT LOT (Black dashed line)
- HERB GRAY PKWY LIMITS (Thick black dashed line)

Manhole Location

- Type: S=Sanitary, R=Storm, C=Combined
- 7R00000 - Manhole Number
- North Invert (N/A)
- South Invert (N/A)
- East Invert (190.00)
- West Invert (190.00)
- Top Elevation (190.00)

Typical Dual Manhole

- Type: Storm, Sanitary
- 7000000 - Manhole Number
- North Invert (N/A)
- South Invert (N/A)
- East Invert (190.00)
- West Invert (190.00)
- Top Elevation (190.00)

Construction Details

- 100.85m 1200mm CP (Orange line)
- S-1000 CONSTRUCTION DWG NUMBER

E9	F9	G9
E10	F10	G10
E11	F11	G11