

NOTE:  
THE INFORMATION ON THIS PLAN IS COMPILED FROM VARIOUS SOURCES AND SHOULD BE VERIFIED PRIOR TO USE.  
LOCATIONS SHOWN ARE APPROXIMATE ONLY AND SHOULD BE VERIFIED IN THE FIELD PRIOR TO WORK COMMENCING.

Table of Revisions


Number	Revision	Date	By
0.	Revised	03-04-14	
	Revised	Oct. 2003	WR/JC
	Revised	June 2004	WR/JC
	Revised	June 2005	WR/JC
	Revised	June 2007	WR
	Added S-1870 Proposed	Oct. 2010	MLR
	Added S-1785 As-Builts	Dec. 2011	MLR
	Added S-1961 As-Builts	May 2016	MLR



The Corporation  
of the  
City of Windsor  
Engineering – Infrastructure & Geomatics



# SEWER ATLAS

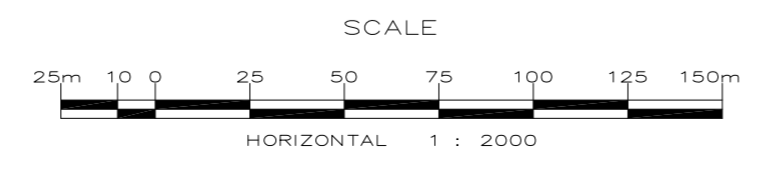

**Legend**

- SANITARY SEWER (Red dashed line)
- STORM SEWER (Blue dashed line)
- COMBINED SEWER (Green dashed line)
- PRIVATE SEWER (Purple dashed line)
- SANITARY PROPOSED OR AS BUILT INFO N/A (Red dashed line with 'P')
- STORM (Blue dashed line with 'S')
- GAS LINE (Yellow dashed line)
- STEAM LINE (Orange dashed line)
- HYDRO ONE (Light blue dashed line)
- R.O.W. (Red dashed line)
- ASSESSMENT LOT (Black dashed line)
- HERB GRAY PKWY LIMITS (Black dashed line)

**Manhole Information**

- Manhole Number: 700000 (Sanitary), 800000 (Storm), 900000 (Combined)
- Manhole Location: North Invert, South Invert, East Invert, West Invert, Top Elevation
- Typical Dual Manhole: Sanitary, Storm
- Construction Dwg Number: S-1000

G5	H5	15
G6	<b>H6</b>	16
G7	H7	17