

NOTE:
THE INFORMATION ON THIS PLAN IS COMPILED FROM VARIOUS SOURCES AND SHOULD BE VERIFIED PRIOR TO USE.
LOCATIONS SHOWN ARE APPROXIMATE ONLY AND SHOULD BE VERIFIED IN THE FIELD PRIOR TO WORK COMMENCING.

Table of Revisions


Number	Revision	Date	By
0.	Revised	Oct. 2003	WR/JC
	Revised	June 2004	WR/JC
	Revised	June 2005	WR/JC
	Revised	June 2007	WR
	Added S-1984 Proposed	May 2014	MLR
	Added S-1984 As-Built	Dec 2014	MLR
	Added S-1996 Pump Station	Jan 2015	MLR
	Added S-2018 Proposed	Dec 2015	MLR



The Corporation
of the
City of Windsor
Engineering – Infrastructure & Geomatics



SEWER ATLAS

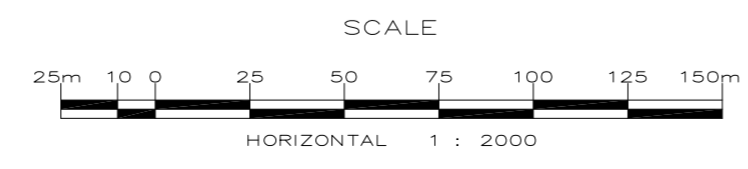

Legend

- SANITARY SEWER (Red dashed line)
- STORM SEWER (Blue dashed line)
- COMBINED SEWER (Green dashed line)
- PRIVATE SEWER (Purple dashed line)
- SANITARY PROPOSED OR AS BUILT INFO N/A (Red dashed line with 'N/A' label)
- STORM PROPOSED OR AS BUILT INFO N/A (Blue dashed line with 'N/A' label)
- GAS LINE (Red solid line)
- STEAM LINE (Blue solid line)
- HYDRO ONE (Red solid line)
- R.O.W. (Red solid line)
- ASSESSMENT LOT (Red solid line)
- HERB GRAY PKWY LIMITS (Red solid line)

Manhole Location

- Manhole Number: 700000
- Typical Dual Manhole: 700000
- North Invert: N/A
- South Invert: N/A
- East Invert: 190.00
- West Invert: 190.00
- Top Elevation: 190.00

Construction Drawing Number

- S-1000

Other Symbols

- Ward
- Manhole Location
- Pipe Length
- Pipe Size
- Pipe Material

L10	M10	N10
L11	M11	N11
L12	M12	N12