



**NOTE:**  
 THE INFORMATION ON THIS PLAN IS COMPILED FROM VARIOUS SOURCES AND SHOULD BE VERIFIED PRIOR TO USE.  
 LOCATIONS SHOWN ARE APPROXIMATE ONLY AND SHOULD BE VERIFIED IN THE FIELD PRIOR TO WORK COMMENCING.

Table of Revisions

M12		Date	By
0.	Revised	01-04-19	
	Revised	03-07-04	
	Revised	Oct. 2003	WR/JC
	Revised	June 2004	WR/JC
	Revised	June 2005	WR/JC
	Revised	June 2007	WR
	Added P-1954	Apr 2012	MLR
	Added P-1954 As-Builts	Mar 2014	MLR




The Corporation  
 of the  
 City of Windsor

Engineering – Infrastructure & Geomatics



# SEWER ATLAS

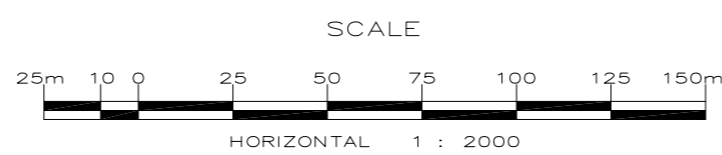

**Legend:**

- SANITARY SEWER (Red dashed line)
- STORM SEWER (Blue dashed line)
- COMBINED SEWER (Green dashed line)
- PRIVATE SEWER (Purple dashed line)
- SANITARY AS BUILT INFO N/A (Red dashed line with 'N/A')
- STORM AS BUILT INFO N/A (Blue dashed line with 'N/A')
- CULVERTS, CATCH BASINS AND OUTLETS (Star symbol)
- GAS LINE (Orange dashed line)
- STEAM LINE (Yellow dashed line)
- HYDRO ONE (Red dashed line with 'H1')
- R.O.W. (Red dashed line with 'R.O.W.')
- ASSESSMENT LOT (Grey shaded area)
- HERB GRAY PKWY LIMITS (Yellow dashed line)

**Manhole Information:**

- Type: S=Sanitary, R=Storm, C=Combined
- Manhole Location: 7R0000 (Manhole Number), N/A (North Invert), N/A (South Invert), 190.00 (East Invert), 190.00 (West Invert), T (Top Elevation)
- Manhole Location: 7D0000 (Manhole Number), N/A (North Invert), N/A (South Invert), 190.00 (East Invert), 190.00 (West Invert), T (Top Elevation)

**Other Symbols:**

- 100.85m 1200mm CP (Green dashed line)
- 100.85m 1200mm CP (Green dashed line)
- S-1000 CONSTRUCTION DWG NUMBER (Red dashed line)

L11	M11	N11
L12	<b>M12</b>	N12
L13	M13	N13