

NOTE:  
 THE INFORMATION ON THIS PLAN IS COMPILED FROM VARIOUS SOURCES AND SHOULD BE VERIFIED PRIOR TO USE.  
 LOCATIONS SHOWN ARE APPROXIMATE ONLY AND SHOULD BE VERIFIED IN THE FIELD PRIOR TO WORK COMMENCING.

Table of Revisions


M3			
Number	Revision	Date	By
0.	Revised	June 2004	WR/JC
	Revised	June 2005	WR/JC
	Revised	June 2007	WR
	Added S-1615 As-built Information	Apr 2010	MLR
	Added S-1846 & S-1879 Proposed	June 2010	MLR
	Added S-1879 As-built	Sep 2014	MLR
	Added S-1987	Jan 2015	MLR
	Added S-1841 As-built	Apr 2015	MLR



The Corporation of the City of Windsor  
 Engineering – Infrastructure & Geomatics



# SEWER ATLAS

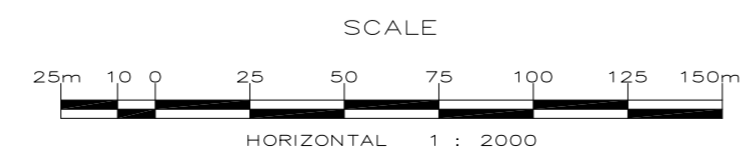

**Legend**

- SANITARY SEWER (Red dashed line)
- STORM SEWER (Blue dashed line)
- COMBINED SEWER (Green dashed line)
- PRIVATE SEWER (Black dashed line)
- SANITARY PROPOSED OR AS BUILT INFO N/A (Red dashed line with 'N/A')
- STORM (Blue dashed line with 'N/A')
- GAS LINE (Yellow dashed line)
- STEAM LINE (Orange dashed line)
- HYDRO ONE (Purple dashed line)
- R.O.W. (Red solid line)
- ASSESSMENT LOT (Black solid line)
- HERB GRAY PKWY LIMITS (Green solid line)

**Manhole Location**

- Manhole Number: 700000
- Typical Dual Manhole: 700000
- North Invert: N/A
- South Invert: N/A
- East Invert: 190.00
- West Invert: 190.00
- Top Elevation: 190.00

**Construction DWG Number**

- Sanitary: [S-1000]
- Storm: [S-1000]

L2	M2	N2
L3	<b>M3</b>	N3
L4	M4	N4